

Tate
H 13
2-6-69

MISSISSIPPI
BOARD OF WATER COMMISSIONERS
416 North State Street
Jackson, Mississippi 39201

CODED
CODEL

WATER WELL DRILLERS LOG

2-6 1969 date well completed
Harris Bros. firm name
Tate county well located

LANDOWNER: George Wooten
pto 2, Box 158
Coldwater
(mailing address)

description of formations encountered	from	to
top soil	0	20
Red sand	20	65
clay + sand	65	125
Coarse sand	125	140

WELL LOCATION:
sec. 4 T. 5 N R. 6 E
2 1/2 miles E of Beth
(distance) (direction) (nearest town)

WELL PURPOSE: none
(home, irrigation, municipal, industrial)

WELL COMPLETION DATA:

(1) diameter (inches) 4

(2) total depth (feet) 140'

(3) static water level (feet) 80' ^{below} ~~above~~ top of ground.

(4) casing Plastic, 133'
(material) (depth)
100 (size) If telescope see back.

(5) screen 7' 133'
(length) (depth to top)
100 Plastic
(size) (material)

(6) pump 3/4 7
(HP) (yield gpm)
eb
(type power)

(7) electric log no
(yes or no)

(organization running log)

(8) how well bottom plugged back
shot

DRILLERS REMARKS:


CODED

MAR 15 1969

MISS. BD. OF
WATER COMM.

If well telescopes please sketch and show depths.

GROUND LEVEL

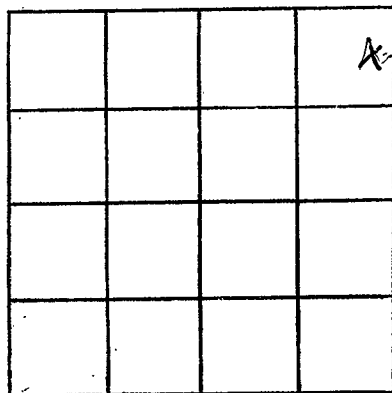

SECTION 4

Please indicate well location X.

ADDITIONAL INFORMATION

If more than one screen,
show locations of each on sketch.