

Tate.
H 14
2-69

MISSISSIPPI
BOARD OF WATER COMMISSIONERS
416 North State Street
Jackson, Mississippi 39201

CODED
CODEL

WATER WELL DRILLERS LOG

2-10 1969 date well completed
Harris Durr Tate firm name
Tate county well located

LANDOWNER: Thomas Harris
Rte 2
Coldwater
(mailing address)
WELL LOCATION:
sec. 10 T. 5 S. R. 6 W.
4 miles SW of Andover
(distance) (direction) (nearest town)

Description of formations encountered	from	to
top soil	0	15
Red sand & clay	15	45
clay	45	60
fine sand	60	85
Coarse sand	85	100

WELL PURPOSE: N/A
(home, irrigation, municipal, industrial)

WELL COMPLETION DATA:

- (1) diameter (inches) 4
- (2) total depth (feet) 100
- (3) static water level (feet) 80 below top of ground.
- (4) casing Plastic 4" (material) 93' (depth)
4" (size) if telescope see back.
- (5) screen 7' 93" (length) (depth to top)
008 Plastic (size) (material)
- (6) pump 3/4 10 (HP) (yield gpm)
elec. (type power)
- (7) electric log NO (yes or no)

(organization running log)


(8) how well bottom plugged
wreck
spat

DRILLERS REMARKS:

CODED
MAR 7 1969
MISS. BD. OF WATER COMMISSIONERS
MISS. BD. OF WATER COMMISSIONERS

If well telescopes please sketch and show depths.

GROUND LEVEL

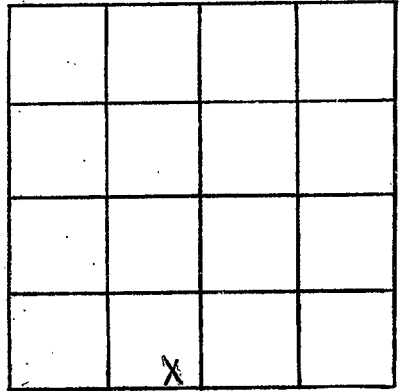

SECTION 10

Please indicate well location X.

ADDITIONAL INFORMATION

If more than one screen,
show locations of each on sketch.