

MISSISSIPPI  
BOARD OF WATER COMMISSIONERS  
416 North State Street  
Jackson, Mississippi 39201

CODED

WATER WELL DRILLERS LOG

TATE  
H 16  
8-15-69

AUG 15 1969 date well completed  
WATSON Co. firm name  
TATE county well located

LANDOWNER: C.C. SMITH  
RT #2

description of formations encountered	from	to
SURFACE CLAY	0	19

COLDWATER, MISS.  
(mailing address)

COARSE SAND & GRAVEL STREAKS	19	61
------------------------------	----	----

WELL LOCATION:  
sec. 6 T. 5 N. R. 6 W.  
6 miles E of COLDWATER  
(distance) (direction) (nearest town)

CLAY	61	63
COARSE SAND	63	102

WELL PURPOSE: FARM  
(home, irrigation, municipal, industrial)

WELL COMPLETION DATA:

(1) diameter (inches) 4"

(2) total depth (feet) 161

(3) static water level (feet) 103 below top of ground.

(4) casing PVC, 146 (material), (depth)

(size) if telescope see back.

(5) screen 15' (length), 146 (depth to top)

4" (size), PVC GRAVEL (material)

(6) pump 5 (HP), 75 G.P.M. (yield gpm)

ELEC (type power)

(7) electric log No (yes or no)

(organization running log)


(8) how well bottom plugged BACK PRESSURE VALVE

DRILLERS REMARKS:

SEP - 8 1969  
MISS. BR. OF WATER DRILLERS

If well telescopes please sketch and show depths.

GROUND LEVEL

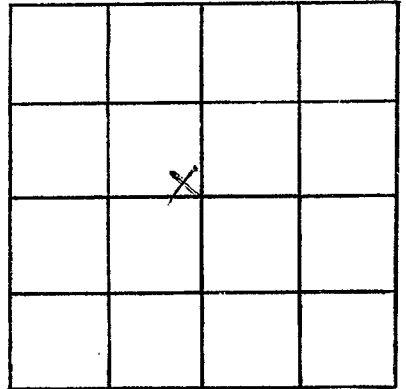

SECTION 6

Please indicate well location X.

ADDITIONAL INFORMATION

If more than one screen,  
show locations of each on sketch.