

Tate Co
H 17
10-69

MISSISSIPPI
BOARD OF WATER COMMISSIONERS
416 North State Street
Jackson, Mississippi 39201

WATER WELL DRILLERS LOG


10-19-1969 Bob Smith Tate
date well completed firm name county well located

LANDOWNER:	description of formations encountered	from	to
Hensley Bar, Miss. (mailing address)	top soil red clay red gravel white sand & clay red top sand	0 3 15 40 80	3 15 20 80 200
WELL LOCATION: sec. 25 T 5 N R 6 E 0 miles of Bar (distance) (direction) (nearest town)			
WELL PURPOSE: Home (home, irrigation, municipal, industrial)			
WELL COMPLETION DATA: (1) diameter (inches) 4 (2) total depth (feet) 200 (3) static water level (feet) 140 below top of ground. (4) casing O-lath 200 (material), (depth) (size) If telescope see back. (5) screen 20 180 (length), (depth to top) 4 O-lath (size), (material) (6) pump 3/4 15 (HP), (yield gpm) Ples (type power) (7) electric log no (yes or no) (organization running log) (8) how well bottom plugged plugged			
DRILLERS REMARKS: good drilling			

DEC - 9 1969
MISS. BD. OF
WATER COMMISSIONERS

If well telescopes please sketch and show depths.

GROUND LEVEL

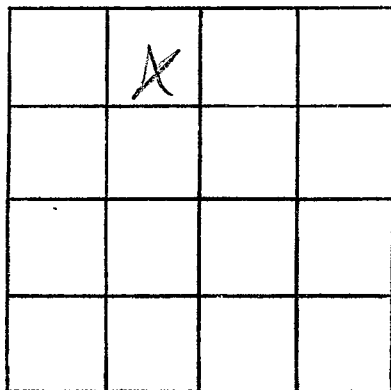

SECTION _____

Please indicate well location X.

ADDITIONAL INFORMATION

If more than one screen, show locations of each on sketch.