

TATE
H 19
5-10-69

MISSISSIPPI
BOARD OF WATER COMMISSIONERS
416 North State Street
Jackson, Mississippi 39201

CODED

WATER WELL DRILLERS LOG


5-10 1969 Harris Bros. Tate
date well completed firm name county well located

LANDOWNER: Robert W. Weather	description of formations encountered	from	to
ato 1			
Sanatobia (mailing address)	top sub	0	25
	red sand	25	60
	fine sand	60	110
	clay & sand	110	195
	course sand	195	220
WELL LOCATION:			
sec 25 T 5 N R 6 E 9 miles E of Sanatobia (distance) (direction) (nearest town)			
WELL PURPOSE: (home, irrigation, municipal, industrial)			
WELL COMPLETION DATA:			
(1) diameter (inches) 4"			
(2) total depth (feet) 220			
(3) static water level (feet) 220 below top of ground.			
(4) casing Plastic, 206 (material) (depth) 4" (size) if telescope see back.			
(5) screen 14', 206 (length) (depth to top) 208, Plastic (size) (material)			
(6) pump 3/4 7 (HP) (yield gpm) elec. (type power)			
(7) electric log no (yes or no) (organization running log)			
(8) how well bottom plugged wash shot			
DRILLERS REMARKS:			

DEC 22 1969
MKS. PL. OF
WATER COMM.

If well telescopes please sketch and show depths.

GROUND LEVEL

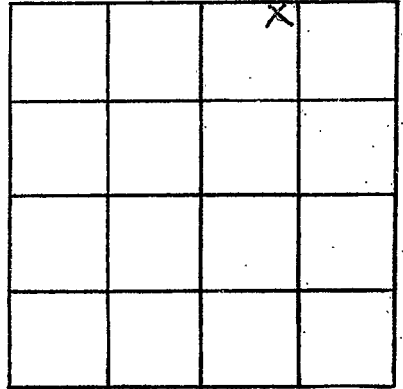

SECTION 25

Please indicate well location X.

ADDITIONAL INFORMATION

If more than one screen,
show locations of each on sketch.