

TATE
H 20
6-3-69

MISSISSIPPI
BOARD OF WATER COMMISSIONERS
416 North State Street
Jackson, Mississippi 39201

CODED


WATER WELL DRILLERS LOG

6-3 1969 Harris Bros. Tate
date well completed firm name county well located

LANDOWNER: <u>Sidney Williams</u>	description of formations encountered	from	to
<u>pte 2</u> <u>Coldwater</u> (mailing address)	<u>top soil</u>	0	20
WELL LOCATION: sec. <u>7</u> T. <u>5</u> N. R. <u>6</u> E. <u>3</u> miles <u>W</u> of <u>Prayville</u> (distance) (direction) (nearest town)	<u>sand</u>	20	65
WELL PURPOSE: <u>none</u> (home, irrigation, municipal, industrial)	<u>clay + fine sand</u>	65	135
WELL COMPLETION DATA: (1) diameter (inches) <u>4</u> (2) total depth (feet) <u>160</u> (3) static water level (feet) <u>100</u> <u>below</u> top of ground. (4) casing <u>Plastic, 146'</u> (material) (depth) <u>4'</u> (size) if telescope see back. (5) screen <u>14'</u> (length) <u>146'</u> (depth to top) <u>.008, Plastic</u> (size) (material) (6) pump <u>3/4</u> (HP) <u>7</u> (yield gpm) <u>elec.</u> (type power) (7) electric log <u>no</u> (yes or no) <u></u> (organization running log) (8) how well bottom plugged <u>back</u> <u>spit</u>	<u>coarse sand</u>	135	160
DRILLERS REMARKS:	<p>DEC 22 1969 MISS. BD. OF WATER COMMISSIONERS</p>		

If well telescopes please sketch and show depths.

GROUND LEVEL

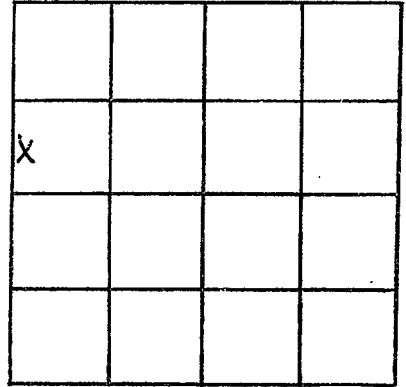

SECTION _____

Please indicate well location X.

ADDITIONAL INFORMATION

If more than one screen, show locations of each on sketch.