

TATE
H 21
8-4-69

MISSISSIPPI
BOARD OF WATER COMMISSIONERS
416 North State Street
Jackson, Mississippi 39201

CODED


WATER WELL DRILLERS LOG

8-4 1969 Harris Bros. Tate
date well completed firm name county well located

LANDOWNER: James Willson pte 2.	description of formations encountered	from to
Coldwater (mailing address)	top soil	0 15
WELL LOCATION: sec. 9 T-5 N R-6 E 5 miles SW of Independence (distance) (direction) (nearest town)	red sand	15 60
WELL PURPOSE: home (home, irrigation, municipal, industrial)	clay + sand	60 95
WELL COMPLETION DATA: (1) diameter (inches) 4 (2) total depth (feet) 110 (3) static water level (feet) 110 below above top of ground. (4) casing Plastic, 103 (material) (depth) 4" (size) if telescope see back. (5) screen 7' 103 (length) (depth to top) 008 Plastic (size) (material) (6) pump 74 7 (HP) (yield gpm) elec. (type power) (7) electric log no (yes or no) (organization running log) (8) how well bottom plugged wash spot	coarse sand	95 110
DRILLERS REMARKS:	DEC 22 1969 MISS. DD. 25 WATER COM.	

If well telescopes please sketch and show depths.

GROUND LEVEL

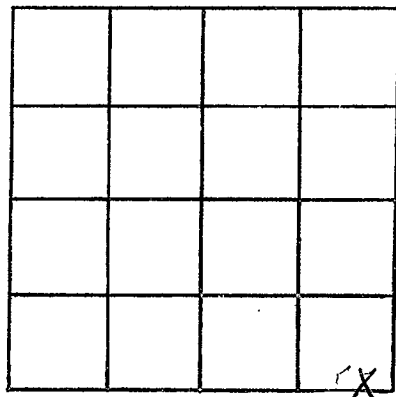

SECTION 9

Please indicate well location X.

ADDITIONAL INFORMATION

If more than one screen, show locations of each on sketch.