

TATE
H 23
8-18-69

MISSISSIPPI
BOARD OF WATER COMMISSIONERS
416 North State Street
Jackson, Mississippi 39201

CODED

WATER WELL DRILLERS LOG

8-18-69 date well completed
Harris Bros firm name
Tate county well located

LANDOWNER: S. D. Wallace

description of formations encountered from to

Rte 1
Coldwater
(mailing address)

top soil	0	20
red sand	20	50
clay sand	50	120
coarse sand	120	140

WELL LOCATION:
sec. 7 T. 5 N. R. 6 E.
5 miles S of Poplarville
(distance) (direction) (nearest town)

WELL PURPOSE: home
(home, irrigation, municipal, industrial)

WELL COMPLETION DATA:

- (1) diameter (inches) 4"
- (2) total depth (feet) 140
- (3) static water level (feet) 20 below top of ground.
- (4) casing Plastic, 133' (material) (depth)
4" (size) If telescope see back.
- (5) screen 7' 133' (length) (depth to top)
008 Plastic (size) (material)
- (6) pump 1/4 (HP) 7 (yield gpm)
elec. (type power)
- (7) electric log no (yes or no)

(organization running log)

(8) how well bottom plugged much
short


DEC 29 1969

DRILLERS REMARKS:

MISS. BD. OF
WATER COM.

If well telescopes please sketch and show depths.

GROUND LEVEL

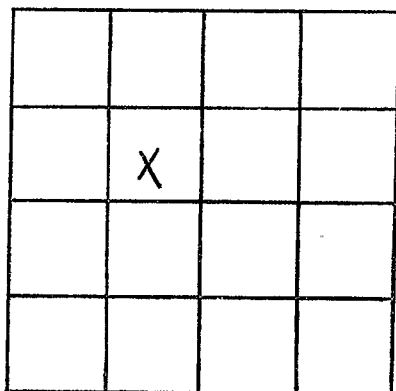

SECTION 7

Please indicate well location X.

ADDITIONAL INFORMATION

If more than one screen,
show locations of each on sketch.