

MISSISSIPPI
BOARD OF WATER COMMISSIONERS
416 North State Street
Jackson, Mississippi 39201

CODED

WATER WELL DRILLERS LOG

TATE
H 24
10-4-69

10-4 1969 date well completed
Harris Bros. firm name
Tate county well located

LANDOWNER: Joe Buford

Rte 2

Coldwater

(mailing address)

WELL LOCATION:

sec 24 T 5 N R 6 E
13 miles E of Senatobia
(distance) (direction) (nearest town)

WELL PURPOSE: home
(home, irrigation, municipal, industrial)

WELL COMPLETION DATA:

- (1) diameter (inches) 4
- (2) total depth (feet) 180'
- (3) static water level (feet) 100' (below above top of ground)
- (4) casing Plastic, 166'
(material) (depth)
4" (size) if telescope see back.
- (5) screen 14" length, 166' depth to top
100' Plastic (size) (material)
- (6) pump 3/4 HP, 7 yield gpm
elec. (type power)
- (7) electric log no (yes or no)

(organization running log)

(8) how well bottom plugged with shot

description of formations encountered

from to

top soil	0	20
red sand	20	50
white clay	50	95
fine sand	95	155
Coarse sand	155	180


DRILLERS REMARKS:

DEC 29 1969

MISS. BD. OF
WATER COMM.

If well telescopes please sketch and show depths.

GROUND LEVEL

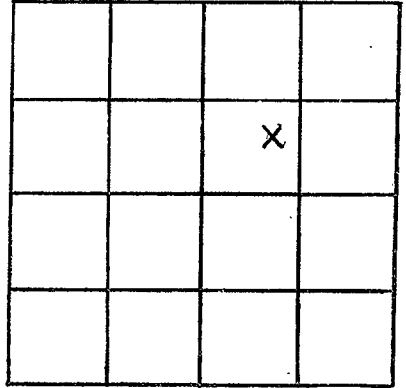

SECTION 24

Please indicate well location X.

ADDITIONAL INFORMATION

If more than one screen, show locations of each on sketch.