

**MISSISSIPPI  
BOARD OF WATER COMMISSIONERS**  
416 North State Street  
Jackson, Mississippi 39201

**CODED**

TATE
H26
10-16-69

**WATER WELL DRILLERS LOG**

10-16-1969 date well completed      Harris Bros. Tate firm name      Tate county well located


LANDOWNER:	description of formations encountered	from	to
Paul Harris Rto 2, Box 106 Coldwater (mailing address)			
WELL LOCATION: sec. 1 T 5 N R 6 E 3 miles SE of Independence (distance) (direction) (nearest town)	red sand	20	65
WELL PURPOSE: none (home, irrigation, municipal, industrial)	sand + clay	65	115
WELL COMPLETION DATA: (1) diameter (inches) 4 (2) total depth (feet) <del>130</del> 130 (3) static water level (feet) 60 below above top of ground (4) casing 4" (material) 123 (depth) if telescope see back. (5) screen 7' (length) 123 (depth to top) e08 (size) Plaster (material) (6) pump 3/4 (HP) 7 (yield gpm) elec. (type power) (7) electric log no (yes or no) (organization running log) (8) how well bottom plugged back shot	concrete sand	115	130
DRILLERS REMARKS:			

DEC 29 1969

MISS. BD. OF  
WATER COMM.

If well telescopes please sketch and show depths.

GROUND LEVEL

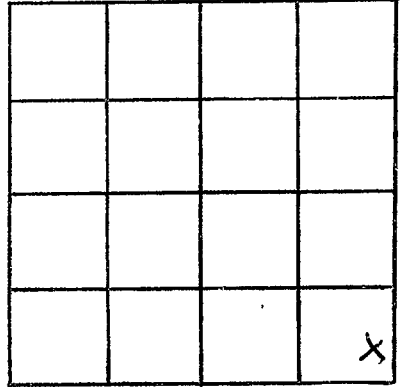

SECTION 1

Please indicate well location X.

ADDITIONAL INFORMATION

If more than one screen, show locations of each on sketch.