

**MISSISSIPPI  
BOARD OF WATER COMMISSIONERS**  
416 North State Street  
Jackson, Mississippi 39201

**CODED**

**WATER WELL DRILLERS LOG**

TATE  
H 27  
11-27-69

11-27 1969 Harris Bros. Tate  
date well completed firm name county well located


LANDOWNER: <u>Marvin Newson</u>	description of formations encountered	from	to
<u>Rte 2.</u>			
<u>Coldwater</u> (mailing address)	<u>top soil</u>	<u>0</u>	<u>15</u>
<b>WELL LOCATION:</b> sec. <u>12</u> T. <u>5</u> N. R. <u>6</u> E <u>4</u> miles <u>S</u> of <u>Anderson</u> (distance) (direction) (nearest town)	<u>red sand</u>	<u>15</u>	<u>40</u>
<b>WELL PURPOSE:</b> <u>none</u> (home, irrigation, municipal, industrial)	<u>sand + clay</u>	<u>40</u>	<u>90</u>
<b>WELL COMPLETION DATA:</b>	<u>Coarse sand</u>	<u>90</u>	<u>100</u>
(1) diameter (inches) <u>4"</u>			
(2) total depth (feet) <u>100</u>			
(3) static water level (feet) <u>60</u> <u>below</u> above top of ground.			
(4) casing <u>Plastic</u> , <u>93'</u> (material) (depth)			
<u>4"</u> if telescope see back. (size)			
(5) screen <u>7'</u> , <u>93'</u> (length) (depth to top)			
<u>008 Plastic</u> (size) (material)			
(6) pump <u>3/4</u> , <u>7</u> (HP) (yield gpm)			
<u>elec.</u> (type power)			
(7) electric log <u>no</u> (yes or no)			
<u></u> (organization running log)			
(8) how well bottom plugged <u>much</u> <u>shot</u>			
<b>DRILLERS REMARKS:</b>			

DEC 20 1969

MISS. BD. OF  
WATER COMMISSIONERS

If well telescopes please sketch and show depths.

GROUND LEVEL

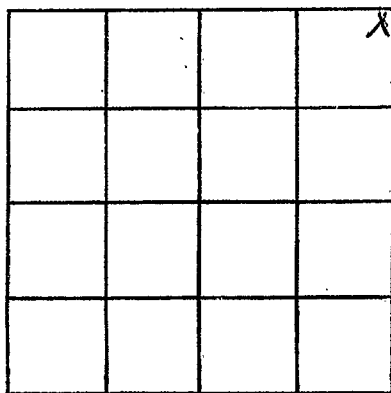

SECTION 12

Please indicate well location X.

ADDITIONAL INFORMATION

If more than one screen,  
show locations of each on sketch.