

MISSISSIPPI
BOARD OF WATER COMMISSIONERS
416 North State Street
Jackson, Mississippi 39201

CODED

WATER WELL DRILLERS LOG

TATE
H 28
1-23-70

1-23 1970 date well completed Harris Bros. firm name Tate county well located

LANDOWNER: L.S. Partee
Rt. 1
Senatobia
(mailing address)

description of formations encountered	from	to
top soil	0	15
clay	15	40
fine sand	40	80
course sand	80	100

WELL LOCATION:
sec. 20 T 5 N R 6 E
2 3/4 miles N of Senatobia
(distance) (direction) (nearest town)

WELL PURPOSE: home
(home, irrigation, municipal, industrial)

- WELL COMPLETION DATA:
- (1) diameter (inches) 4
 - (2) total depth (feet) 100
 - (3) static water level (feet) ~~100~~ 30 ^{below} top of ground.
 - (4) casing Plastic, 93
(material) (depth)
4 if telescope see back.
(size)
 - (5) screen 7' 93
(length) (depth to top)
008 Plastic
(size) (material)
 - (6) pump 3/4 7
(HP) (yield gpm)
elec.
(type power)
 - (7) electric log NO
(yes or no)

(organization running log)
(8) how well bottom plugged back
short


DRILLERS REMARKS:

FEB 18 1970

MISS. BD. OF
WATER COMM.

If well telescopes please sketch and show depths.

GROUND LEVEL

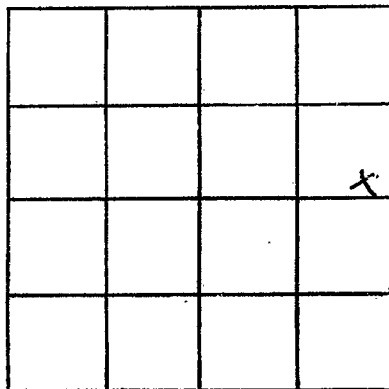

SECTION 20

Please indicate well location X.

ADDITIONAL INFORMATION

If more than one screen, show locations of each on sketch.