

Tate Co
 H 30
 2-25-70
 3 CB

MISSISSIPPI
 BOARD OF WATER COMMISSIONERS
 416 North State Street
 Jackson, Mississippi 39201

WATER WELL DRILLERS LOG


2-25 1970 date well completed
 Harris Bros. firm name
 Tate county well located

LANDOWNER, <i>Joseph May</i>	description of formations encountered	from	to
<i>Rt. 2</i>			
<i>Coldwater</i> (mailing address)	<i>top soil</i>	<i>0</i>	<i>15</i>
WELL LOCATION: sec. <i>2</i> T. <i>5</i> N. R. <i>6</i> E. <i>100</i> <i>1 1/2</i> miles <i>S</i> of <i>Andropose</i> (distance) (direction) (nearest town)	<i>sand</i>	<i>15</i>	<i>35</i>
WELL PURPOSE: <i>home</i> (home, irrigation, municipal, industrial)	<i>clay & sand</i>	<i>35</i>	<i>85</i>
WELL COMPLETION DATA: (1) diameter (inches) <i>4"</i>	<i>course sand</i>	<i>85</i>	<i>100</i>
(2) total depth (feet) <i>100'</i>			
(3) static water level (feet) <i>60</i> ^{below} above top of ground.			
(4) casing <i>plastic</i> , <i>93'</i> (material) (depth)			
<i>4"</i> if telescope see back. (size)			
(5) screen <i>7'</i> , <i>93'</i> (length) (depth to top)			
<i>1/8"</i> , <i>plastic</i> (size) (material)			
(6) pump <i>3/4</i> , <i>7</i> (HP) (yield gpm)			
<i>elec.</i> (type power)			
(7) electric log <i>no</i> (yes or no)			
(organization running log)			
(8) how well bottom plugged <i>back</i> <i>short</i>			
DRILLERS REMARKS:			

MISS. BO. OF WATER COM. JUN 7 1970

If well telescopes please sketch and show depths.

GROUND LEVEL

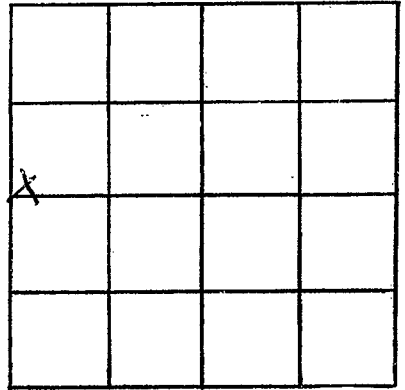

SECTION 2

Please indicate well location X.

ADDITIONAL INFORMATION

If more than one screen,
show locations of each on sketch.