

Tate Co
H 32
3-15-70

MISSISSIPPI
BOARD OF WATER COMMISSIONERS
416 North State Street
Jackson, Mississippi 39201

3 BB WATER WELL DRILLERS LOG

3-15 1970 date well completed
Harris Bros. firm name
Tate county well located

LANDOWNER: Kenneth Powell
pt. 2
Coldwater
(mailing address)
WELL LOCATION: 100
sec. 9 T S N R 6 E
3 1/2 miles SW of Andover
(distance) (direction) (nearest town)

description of formations encountered	from	to
top soil	0	15
red sand	15	30
white clay + sand	30	105
coarse sand	105	120

WELL PURPOSE: home
(home, irrigation, municipal, industrial)

- WELL COMPLETION DATA:
- (1) diameter (inches) 4"
 - (2) total depth (feet) 120'
 - (3) static water level (feet) 80' ^{below} above top of ground.
 - (4) casing plaster, 113'
(material) (depth)
4" if telescope see back.
(size)
 - (5) screen 7', 113'
(length) (depth to top)
008, plaster
(size) (material)
 - (6) pump 3/4, 10
(HP) (yield gpm)
elec.
(type power)
 - (7) electric log yes
(yes or no)
 - (organization running log)
 - (8) how well bottom plugged brush
strut


DRILLERS REMARKS:

JUN 11 1970

MISS. BD. OF
WATER COMM.

If well telescopes please sketch and show depths.

GROUND LEVEL

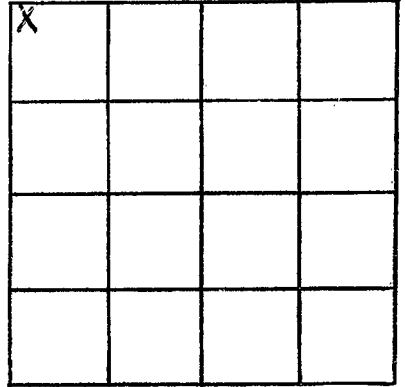

SECTION 9

Please indicate well location X.

ADDITIONAL INFORMATION

If more than one screen, show locations of each on sketch.