

MISSISSIPPI  
 BOARD OF WATER COMMISSIONERS  
 416 North State Street  
 Jackson, Mississippi 39201

Tate Co  
 H33  
 5-1-70  
 3 CD

WATER WELL DRILLERS LOG

5-1 1970 date well completed  
 Harris Bros. firm name  
 Tate county well located


LANDOWNER <u>Cecil Compton</u>	description of formations encountered	from	to
<u>pt. 2</u>	<u>top soil</u>	<u>0</u>	<u>15</u>
<u>Coldwater</u>	<u>clay + sand</u>	<u>15</u>	<u>25</u>
(mailing address)			
WELL LOCATION: sec. <u>7</u> T <u>S</u> N R. <u>6</u> E <u>100</u> <u>2</u> miles <u>S</u> of <u>Prosser</u> (distance) (direction) (nearest town)	<u>Coarse sand</u>	<u>25</u>	<u>100</u>
WELL PURPOSE: <u>home</u> (home, irrigation, municipal, industrial)			
WELL COMPLETION DATA:			
(1) diameter (inches) <u>4</u>			
(2) total depth (feet) <u>100</u>			
(3) static water level (feet) <u>60</u> <small>below above</small> top of ground.			
(4) casing <u>Plastic</u> , <u>93'</u> (material) (depth)			
<u>4</u> if telescope see back. (size)			
(5) screen <u>7'</u> , <u>93'</u> (length) (depth to top)			
(6) pump <u>3/4</u> , <u>Plastic</u> (size) (material)			
(6) pump <u>3/4</u> , <u>7</u> (HP) (yield gpm)			
(6) pump <u>ele.</u> (type power)			
(7) electric log <u>no</u> (yes or no)			
(organization running log)			
(8) how well bottom plugged <u>brack</u> <u>short</u>			
DRILLERS REMARKS:			

JUN 11 1970

MISS. DEPT. OF  
 WATER CONSV.

If well telescopes please sketch and show depths.

GROUND LEVEL

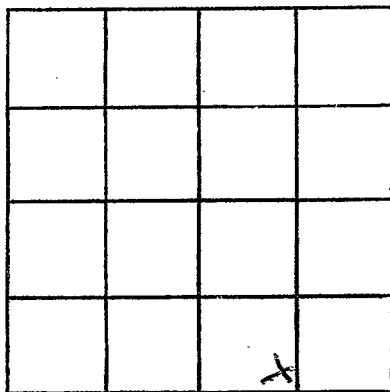

SECTION 7

Please indicate well location X.

ADDITIONAL INFORMATION

If more than one screen, show locations of each on sketch.