

MISSISSIPPI
BOARD OF WATER COMMISSIONERS
416 North State Street
Jackson, Mississippi 39201

CODED

WATER WELL DRILLERS LOG

TATE
H 37
10-20-70

10-20 1970 Harris Bros. Tate
date well completed firm name county well located

LANDOWNER: B.B. Hawkins
pt. 1
Coldwater
(mailing address)

description of formations encountered	from	to
<u>top sub</u>	<u>0</u>	<u>20</u>
<u>red sand & clay</u>	<u>20</u>	<u>55</u>
<u>grey clay</u>	<u>55</u>	<u>115</u>
<u>fine sand</u>	<u>115</u>	<u>150</u>
<u>coarse sand</u>	<u>150</u>	<u>170</u>

WELL LOCATION:
sec. 5 T. 5 N. R. 6 E
1 1/2 miles SE of Pragnville
(distance) (direction) (nearest town)

WELL PURPOSE: none
(home, irrigation, municipal, industrial)

- WELL COMPLETION DATA:
- diameter (inches) 4
 - total depth (feet) 170
 - static water level (feet) 80 (below above top of ground)
 - casing plastic, 156
(material) (depth)
4 If telescope see back.
(size)
 - screen 14, 156
(length) (depth to top)
008, plastic
(size) (material)
 - pump 3/4, 7
(HP) (yield gpm)
elec.
(type power)
 - electric log no
(yes or no)

CODED

MAY 3 1971


(organization running log)
(8) how well bottom plugged brick
shot

MISS. BD. OF
WATER COMMISSIONERS

DRILLERS REMARKS:

If well telescopes please sketch and show depths.

GROUND LEVEL

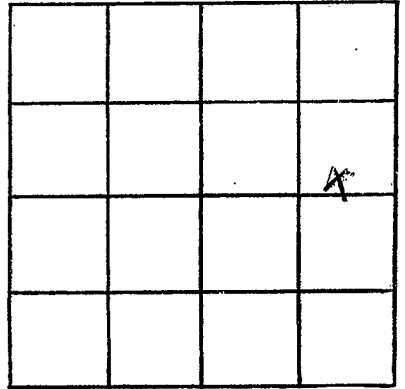

SECTION 5

Please indicate well location X.

ADDITIONAL INFORMATION

If more than one screen, show locations of each on sketch.