

MISSISSIPPI
BOARD OF WATER COMMISSIONERS
416 North State Street
Jackson, Mississippi 39201

WATER WELL DRILLERS LOG

CODED


TATE
H 39
11-10-70

11-10 1970 Harris Bros. Tate
date well completed firm name county well located

LANDOWNER: <u>Marcus Taylor</u> Pt. #1	description of formations encountered	from	to
<u>Senatobia</u> (mailing address)	top soil	0	15
WELL LOCATION: sec <u>22</u> T <u>S</u> N R <u>6</u> E <u>5</u> miles <u>S</u> of <u>Independence</u> (distance) (direction) (nearest town)	clay + sand	15	105
WELL PURPOSE: <u>home</u> (home, irrigation, municipal, industrial)	course sand	105	120
WELL COMPLETION DATA: (1) diameter (inches) <u>4</u> (2) total depth (feet) <u>120</u> (3) static water level (feet) <u>80</u> ^{below} above top of ground. (4) casing <u>Plastic</u> , <u>113</u> , (material) (depth) <u>4</u> if telescope see back. (size) (5) screen <u>7'</u> , <u>113</u> (length) (depth to top) <u>no8</u> , <u>Plastic</u> (size) (material) (6) pump <u>3/4</u> <u>7</u> (HP) (yield gpm) <u>elec</u> (type power) (7) electric log <u>no</u> (yes or no) (organization running log) (8) how well bottom plugged <u>back</u> <u>shot</u>	<p style="text-align: center; font-size: 2em; font-weight: bold;">CODED</p> <p style="text-align: center; font-size: 1.2em; font-weight: bold;">MAY 12 1971</p> <p style="text-align: center; font-size: 0.8em;">MISS. BD. OF WATER COMM.</p>		
DRILLERS REMARKS:			

If well telescopes please sketch and show depths.

GROUND LEVEL

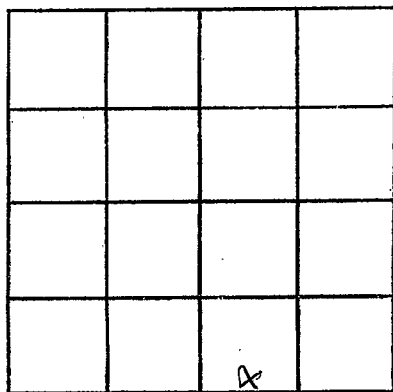

SECTION 22

Please indicate well location X.

ADDITIONAL INFORMATION

If more than one screen,
show locations of each on sketch.