

TATE  
H 40  
12-15-70

MISSISSIPPI  
BOARD OF WATER COMMISSIONERS  
416 North State Street  
Jackson, Mississippi 39201

WATER WELL DRILLERS LOG

**CODED**

12-15 1970  
date well completed

Harris Bros. Tate  
firm name

county well located

LANDOWNER: Willie Newsome

description of formations encountered

from to

pt. 1

Lenatobia

(mailing address)

top soil

0 15

clay + fine sand

15 85

course sand

85 100

WELL LOCATION:

sec. 21 T. 5 N R. 6 E  
2 miles N of Loophole  
(distance) (direction) (nearest town)

WELL PURPOSE: home  
(home, irrigation, municipal, industrial)

WELL COMPLETION DATA:

- (1) diameter (inches) 4
- (2) total depth (feet) 100
- (3) static water level (feet) 60 <sup>below</sup> above top of ground.
- (4) casing Plastic, 93  
(material) (depth)  
4 If telescope see back.  
(size)
- (5) screen 7', 93  
(length) (depth to top)  
008, Plastic  
(size) (material)
- (6) pump 3/4 7  
(HP) (yield gpm)  
elec.  
(type power)
- (7) electric log no  
(yes or no)

(organization running log)

(8) how well bottom plugged buck  
shats

**CODED**


MAY 11 1971

MISS. BD. OF  
WATER COMMISSIONERS

DRILLERS REMARKS:

If well telescopes please sketch and show depths.

GROUND LEVEL

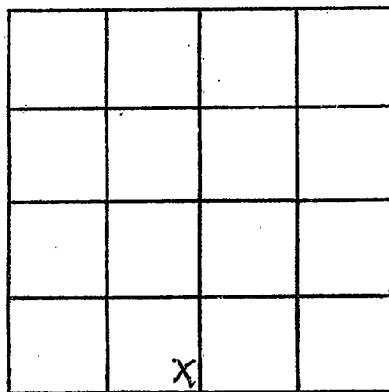

SECTION 21

Please indicate well location X.

ADDITIONAL INFORMATION

If more than one screen,  
show locations of each on sketch.