

TATE
H41
4-15-71

MISSISSIPPI
BOARD OF WATER COMMISSIONERS
416 North State Street
Jackson, Mississippi 39201

CODED

WATER WELL DRILLERS LOG

4-15 19 71 Harris Bros. Tate
date well completed firm name county well located

LANDOWNER: Z. H. Walker
Pt. 2
Coldwater
(mailing address)

description of formations encountered	from	to
top soil	0	15
red sand	15	60
clay & sand	60	125
coarse sand	125	140

WELL LOCATION:
sec. 9 T 5 N R 6 E
3 miles SW of Coldwater
(distance) (direction) (nearest town)

WELL PURPOSE: home
(home, irrigation, municipal, industrial)

- WELL COMPLETION DATA:
- (1) diameter (inches) 4
 - (2) total depth (feet) 140
 - (3) static water level (feet) 80 ^{below}/_{above} top of ground.
 - (4) casing Plastic, 133
(material) (depth)
4 (size) if telescope see back.
 - (5) screen 7' 133
(length) (depth to top)
008, Plastic
(size) (material)
 - (6) pump 3/4 7
(HP) (yield gpm)
clean
(type power)
 - (7) electric log no
(yes or no)

CODED

(organization running log)

(8) how well bottom plugged
weck
seal


DRILLERS REMARKS:

MAY 14 1971

MISS. BD. OF
WATER COMMISSIONERS

If well telescopes please sketch and show depths.

GROUND LEVEL

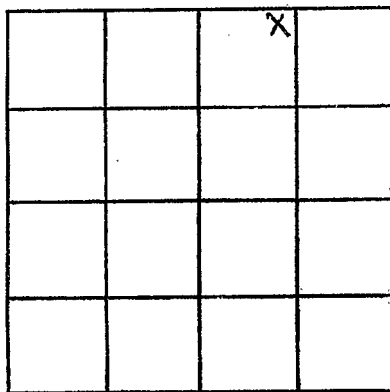

SECTION 9

Please indicate well location X.

ADDITIONAL INFORMATION

If more than one screen, show locations of each on sketch.