

MISSISSIPPI
BOARD OF WATER COMMISSIONERS
416 North State Street
Jackson, Mississippi 39201

CODED

WATER WELL DRILLERS LOG

TATE
H-42
6-8-71

6-8-1971 *Bob Smith* *Tate*
date well completed firm name county well located

LANDOWNER:	description of formations encountered	from	to
<i>Jones Fly</i> <i>Senatobia, Miss.</i> (mailing address)			
WELL LOCATION:			
sec. <i>23</i> T. <i>5</i> N. R. <i>6</i> E <i>9</i> miles <i>EAST</i> of <i>Senatobia</i> (distance) (direction) (nearest town)			
WELL PURPOSE: <i>None</i> (home, irrigation, municipal, industrial)			
WELL COMPLETION DATA:			
(1) diameter (inches) <i>4</i>			
(2) total depth (feet) <i>130</i>			
(3) static water level (feet) <i>80</i> below above top of ground.			
(4) casing <i>Plastic</i> , <i>130</i> (material) (depth)			
(size) If telescope see back.			
(5) screen <i>20</i> , <i>110</i> (length) (depth to top)			
(size), <i>Plastic</i> (material)			
(6) pump <i>1/3</i> , <i>10</i> (HP) (yield gpm)			
<i>Electric</i> (type power)			
(7) electric log <i>no</i> (yes or no)			
(organization running log)			
(8) how well bottom plugged <i>plugged</i>			
DRILLERS REMARKS:			


CODED

AUG 6 - 1971

MISS. BD. OF
WATER COMMISSIONERS

If well telescopes please sketch and show depths.

GROUND LEVEL

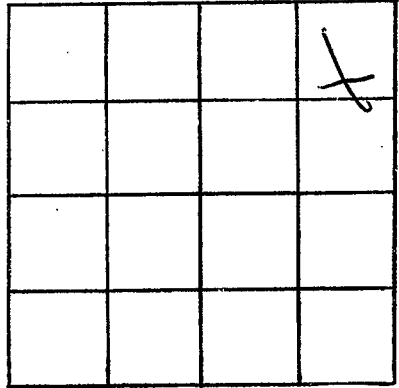

SECTION _____

Please indicate well location X.

ADDITIONAL INFORMATION

If more than one screen,
show locations of each on sketch.