

TATE  
H-43  
6-26-71

MISSISSIPPI  
BOARD OF WATER COMMISSIONERS  
416 North State Street  
Jackson, Mississippi 39201

WATER WELL DRILLERS LOG

**CODED**

6-26 1971 Bob Smith Tate  
date well completed firm name county well located

LANDOWNER:  
Bob Coleman  
Coldwater, Miss.  
(mailing address)

description of formations encountered	from	to
top soil	0	5
red gravel	5	60
red clay	60	100
lime whorl	100	130
coarse sand	130	160

WELL LOCATION:  
sec 20 T 5 N R 6 E  
8 miles S East of Coldwater  
(distance) (direction) (nearest town)

WELL PURPOSE: Home  
(home, irrigation, municipal, industrial)

- WELL COMPLETION DATA:
- (1) diameter (inches) 4
  - (2) total depth (feet) 160
  - (3) static water level (feet) 80 below top of ground.
  - (4) casing P. lath, 160  
(material), (depth)  
(size) if telescope see back.
  - (5) screen 20, 140  
(length), (depth to top)  
4, P. lath  
(size), (material)
  - (6) pump 1, 20  
(HP), (yield gpm)  
E. lue  
(type power)
  - (7) electric log no  
(yes or no)
  - (organization running log)
  - (8) how well bottom plugged plugged


**CODED**

AUG 6 - 1971

DRILLERS REMARKS:

If well telescopes please sketch and show depths.

GROUND LEVEL

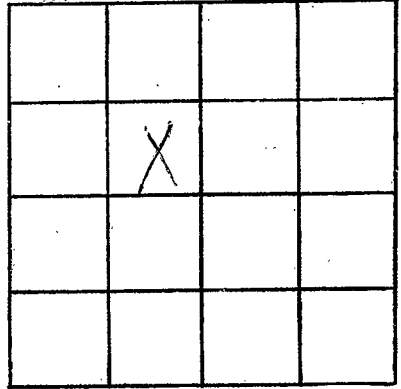

SECTION \_\_\_\_\_

Please indicate well location X.

ADDITIONAL INFORMATION

If more than one screen, show locations of each on sketch.