

TATE  
H 44  
5-15-71

MISSISSIPPI  
BOARD OF WATER COMMISSIONERS DEC 8 1971  
416 North State Street  
Jackson, Mississippi 39201

WATER WELL DRILLERS LOG **CODED**

5-15-71 date well completed 19 71 Harris Bros. firm name Tate county well located

LANDOWNER: S.A. Jackson  
pt. 2  
Coldwater  
(mailing address)

description of formations encountered	from	to
<u>top soil</u>	<u>0</u>	<u>20</u>
<u>clay + sand</u>	<u>20</u>	<u>25</u>
<u>Coarse sand</u>	<u>25</u>	<u>100</u>

WELL LOCATION:  
sec. 9 T. 5 N. R. 6 E.  
2 miles SSE of Praxville  
(distance) (direction) (nearest town)

WELL PURPOSE: none  
(home, irrigation, municipal, industrial)

- WELL COMPLETION DATA:
- (1) diameter (inches) 4
  - (2) total depth (feet) 100
  - (3) static water level (feet) 60 below top of ground.
  - (4) casing Plastic, 93  
(material) (depth)  
4 if telescope see back.  
(size)
  - (5) screen 7', 93  
(length) (depth to top)  
008 Plastic  
(size) (material)
  - (6) pump 3/4, 7  
(HP) (yield gpm)  
elec.  
(type power)
  - (7) electric log no  
(yes or no)


**CODED**

(organization running log)  
(8) how well bottom plugged back  
shot

DRILLERS REMARKS:

If well telescopes please sketch and show depths.

GROUND LEVEL

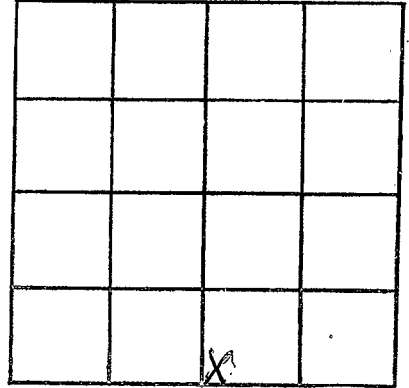

SECTION 9

Please indicate well location X.

ADDITIONAL INFORMATION

A series of horizontal lines for writing additional information.

If more than one screen, show locations of each on sketch.