

TATE
H 46
6-10-71

MISSISSIPPI
BOARD OF WATER COMMISSIONERS
416 North State Street
Jackson, Mississippi 39201

DEC 8 1971

WATER WELL DRILLERS LOG

CODED

6-10-71 date well completed 1971 Harris Bros. firm name county well located

LANDOWNER: Melvin Turner

description of formations encountered

from to

pt. 2
Caldwater
(mailing address)

top soil	0	20
gray clay	20	65
clay + sand	65	135
Coarse sand	135	147

WELL LOCATION:

sec. 6 T. 5 N R. 6 E
3/4 miles W Rayville
(distance) (direction) (nearest town)

WELL PURPOSE: home
(home, irrigation, municipal, industrial)

WELL COMPLETION DATA:

- (1) diameter (inches) 4
- (2) total depth (feet) 147
- (3) static water level (feet) 80 ^{below} above top of ground.
- (4) casing Plastic, 140
(material) (depth)
- 4
(size) if telescope see back.
- (5) screen 7, 140
(length) (depth to top)
- 008 Plastic
(size) (material)
- (6) pump 3/4, 7
(HP) (yield gpm)
- elec
(type power)
- (7) electric log no
(yes or no)

CODED


(organization running log)

(8) how well bottom plugged back
shot

DRILLERS REMARKS:

If well telescopes please sketch and show depths.

GROUND LEVEL

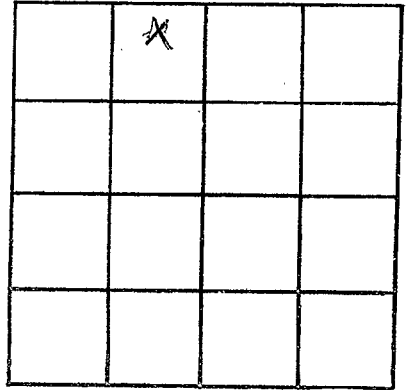

SECTION _____

Please indicate well location X.

ADDITIONAL INFORMATION

If more than one screen,
show locations of each on sketch.