

TATE
H47
6-12-71

MISSISSIPPI
BOARD OF WATER COMMISSIONERS DEC 8 1971
416 North State Street
Jackson, Mississippi 39201

WATER WELL DRILLERS LOG **CODED**

MISS. BD. OF
CODED

6-12 1971 date well completed
Harris Bros. firm name
Lake county well located

LANDOWNER: Johnny Ferguson
Pt. 2
Caldwater
(mailing address)

description of formations encountered	from	to
top soil	0	20
clay	20	65
clay + sand	65	125
Coarse sand	125	140

WELL LOCATION:
sec. 6 T. 5 N R. 6 E
1/2 miles W of Poywill
(distance) (direction) (nearest town)

WELL PURPOSE: home
(home, irrigation, municipal, industrial)

- WELL COMPLETION DATA:
- (1) diameter (inches) 4
 - (2) total depth (feet) 150
 - (3) static water level (feet) 80 ^{below} above top of ground
 - (4) casing plastic, 136
(material) (depth)
4 if telescope see back.
(size)
 - (5) screen 14, 136
(length) (depth to top)
008 plastic
(size) (material)
 - (6) pump 3/4, 10
(HP) (yield gpm)
elc.
(type power)
 - (7) electric log no
(yes or no)


CODED

(organization running log)
(8) how well bottom plugged back
shot

DRILLERS REMARKS:

If well telescopes please sketch and show depths.

GROUND LEVEL

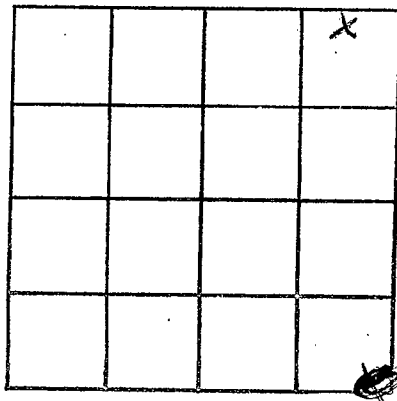

SECTION 6

Please indicate well location X.

ADDITIONAL INFORMATION

If more than one screen, show locations of each on sketch.