

TATE
H50
7-25-71

MISSISSIPPI
 BOARD OF WATER COMMISSIONERS
 416 North State Street
 Jackson, Mississippi 39201

DEC 8 1971
CODED

WATER WELL DRILLERS LOG


7-25-71 date well completed Harris Bros. firm name Tate county well located

| LANDOWNER: <u>Fredonia Church</u> | description of formations encountered | from | to |
|---|---------------------------------------|------------|------------|
| <u>rt. 2</u> | <u>top soil</u> | <u>0</u> | <u>20</u> |
| <u>Coldwater</u> (mailing address) | <u>gravel</u> | <u>20</u> | <u>55</u> |
| WELL LOCATION: sec. <u>9</u> T. <u>5</u> N. R. <u>6</u> E. <u>3</u> miles S of <u>Independence</u> | <u>sand + clay</u> | <u>55</u> | <u>105</u> |
| (distance) (direction) (nearest town) | <u>Coarse sand</u> | <u>105</u> | <u>120</u> |
| WELL PURPOSE: <u>home</u> (home, irrigation, municipal, industrial) | | | |
| WELL COMPLETION DATA: | | | |
| (1) diameter (inches) <u>4</u> | | | |
| (2) total depth (feet) <u>120</u> | | | |
| (3) static water level (feet) <u>80</u> <u>below</u> above top of ground. | | | |
| (4) casing <u>Plastic</u> , <u>113</u> (material) (depth) <u>4</u> if telescope see back. (size) | | | |
| (5) screen <u>7</u> , <u>113</u> (length) (depth to top) <u>008</u> , <u>Plastic</u> (size) (material) | | | |
| (6) pump <u>3/4</u> , <u>7</u> (HP) (yield gpm) <u>elec</u> (type power) | | | |
| (7) electric log <u>no</u> (yes or no) (organization running log) | | | |
| (8) how well bottom plugged <u>back</u> <u>seat</u> | | | |
| DRILLERS REMARKS: | | | |

CODED

If well telescopes please sketch and show depths.

GROUND LEVEL

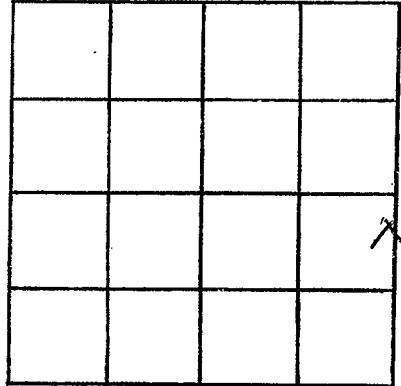

SECTION 9

Please indicate well location X.

ADDITIONAL INFORMATION

If more than one screen,
show locations of each on sketch.