

TATE  
H 51  
3-4-72

MISSISSIPPI  
BOARD OF WATER COMMISSIONERS  
416 North State Street  
Jackson, Mississippi 39201

APR 30 1972


WATER WELL DRILLERS LOG

3-4-1972 Bob Smith T. Tate  
date well completed firm name county well located

LANDOWNER:	description of formations encountered	from	to
J. W. Wright Senatobia, Miss. (mailing address)	top soil red clay sand	0 5 70	5 30 80
<b>WELL LOCATION:</b>			
sec. 21 T 5 N R 6 E 2 miles N of Coahoma (distance) (direction) (nearest town)			
<b>WELL PURPOSE:</b> None (home, irrigation, municipal, industrial)			
<b>WELL COMPLETION DATA:</b>			
(1) diameter (inches) 4			
(2) total depth (feet) 80			
(3) static water level (feet) 12 below top of ground.			
(4) casing Plastic, 80 (material), (depth), (size) if telescope see back.			
(5) screen 20, 60 (length), (depth to top), 4, Plastic (size), (material)			
(6) pump 1/2, 10 (HP), (yield gpm), Elex (type power)			
(7) electric log no (yes or no) (organization running log)			
(8) how well bottom plugged plugged			
<b>DRILLERS REMARKS:</b>			

If well telescopes please  
sketch and show depths.

GROUND LEVEL

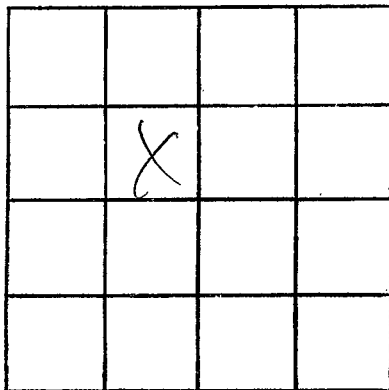

SECTION \_\_\_\_\_

Please indicate well location X.

ADDITIONAL INFORMATION

If more than one screen,  
show locations of each on sketch.