

TATE
H52
12-28-71

MISSISSIPPI
BOARD OF WATER COMMISSIONERS
416 North State Street
Jackson, Mississippi 39201

MAR 20 1972


WATER WELL DRILLERS LOG

12-28-71 date well completed Bob Smith firm name Tate county well located

LANDOWNER:	description of formations encountered	from	to
Ernest Tennell			
Lopalone, Miss. (mailing address)	top soil red clay sand	0 5 40	5 40 107
WELL LOCATION:			
sec. <u>20</u> T. <u>5</u> N. R. <u>6</u> E.			
2 miles N of <u>Looxahoma</u> (distance) (direction) (nearest town)			
WELL PURPOSE: <u>None</u> (home, irrigation, municipal, industrial)			
WELL COMPLETION DATA:			
(1) diameter (inches) <u>4</u>			
(2) total depth (feet) <u>107</u>			
(3) static water level (feet) <u>24</u> below above top of ground.			
(4) casing <u>Plastic</u> , <u>107</u> (material) (depth)			
_____ (size) if telescope see back.			
(5) screen <u>20</u> <u>87</u> (length) (depth to top)			
<u>4</u> , <u>Plastic</u> (size) (material)			
(6) pump <u>1/2</u> <u>10</u> (HP) (yield gpm)			
<u>Electric</u> (type power)			
(7) electric log <u>no</u> (yes or no)			
_____ (organization running log)			
(8) how well bottom plugged <u>plugged</u>			
DRILLERS REMARKS:			

If well telescopes please sketch and show depths.

GROUND LEVEL

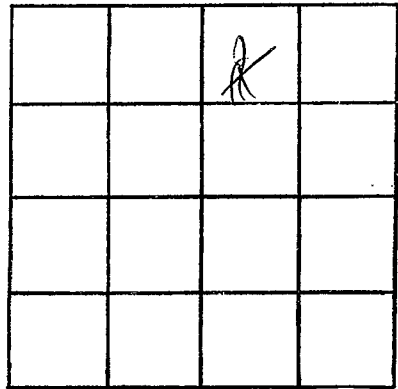

SECTION _____

Please indicate well location X.

ADDITIONAL INFORMATION

If more than one screen,
show locations of each on sketch.