

**TATE**  
**H53**  
**12-11-71**

MISSISSIPPI  
 BOARD OF WATER COMMISSIONERS  
 416 North State Street  
 Jackson, Mississippi 39201

MAR 20 1972


WATER WELL DRILLERS LOG

12-11-1971 Bob Smith Tate  
 date well completed firm name county well located

LANDOWNER:	description of formations encountered	from	to
<u>Herbert Ferguson</u> <u>Andover, Miss.</u> (mailing address)			
WELL LOCATION: sec. <u>3</u> T. <u>5</u> N. R. <u>6</u> E. <u>3</u> miles <u>S</u> of <u>Ind</u> (distance) (direction) (nearest town)			
WELL PURPOSE: <u>Home</u> (home, irrigation, municipal, industrial)			
WELL COMPLETION DATA: (1) diameter (inches) <u>4</u> (2) total depth (feet) <u>130</u> (3) static water level (feet) <u>20</u> below above top of ground. (4) casing <u>Plastic</u> <u>130</u> (material) (depth) (size) If telescope see back. (5) screen <u>20</u> <u>110</u> (length) (depth to top) <u>4</u> <u>Plastic</u> (size) (material) (6) pump <u>1/2</u> <u>10</u> (HP) (yield gpm) <u>Elec</u> (type power) (7) electric log <u>no</u> (yes or no) (organization running log) (8) how well bottom plugged <u>plugged</u>			
DRILLERS REMARKS:			

If well telescopes please sketch and show depths.

GROUND LEVEL

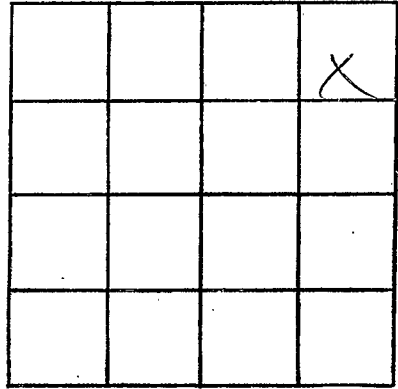

SECTION \_\_\_\_\_

Please indicate well location X.

ADDITIONAL INFORMATION

If more than one screen, show locations of each on sketch.