

TATE
H 55
12-5-71

MISSISSIPPI
 BOARD OF WATER COMMISSIONERS
 416 North State Street
 Jackson, Mississippi 39201

CODED

WATER WELL DRILLERS LOG

12-5 1971 Harris Bros. Tate
 date well completed firm name county well located

LANDOWNER: <u>John Clanton</u>	description of formations encountered	from	to
<u>Rt. 2</u> <u>Coldwater</u> (mailing address)			
WELL LOCATION: sec. <u>1</u> T <u>5</u> N R <u>6</u> E <u>2 1/2</u> miles <u>SE</u> of <u>Independence</u> (distance) (direction) (nearest town)	<u>top soil</u>	<u>0</u>	<u>20</u>
WELL PURPOSE: <u>none</u> (home, irrigation, municipal, industrial)	<u>white clay + sand</u>	<u>20</u>	<u>65</u>
WELL COMPLETION DATA: (1) diameter (inches) <u>4</u>	<u>fine sand</u>	<u>65</u>	<u>125</u>
(2) total depth (feet) <u>140</u>	<u>coarse sand</u>	<u>125</u>	<u>140</u>
(3) static water level (feet) <u>60</u> ^{below} / _{above} top of ground.			
(4) casing <u>Plastic</u> , <u>133'</u> (material) (depth)			
<u>4</u> if telescope see back. (size)			
(5) screen <u>7'</u> , <u>133</u> (length) (depth to top)			
<u>008 Plastic</u> (size) (material)			
(6) pump <u>3/4</u> , <u>7</u> (HP) (yield gpm)			
<u>elec</u> (type power)			
(7) electric log <u>no</u> (yes or no)			
(organization running log)			
(8) how well bottom plugged <u>solid</u>			

CODED


REC - 1077
 FILE - 1 1076

DRILLERS REMARKS:

MISS. BD. OF
 WATER COM'RS

If well telescopes please sketch and show depths.

GROUND LEVEL

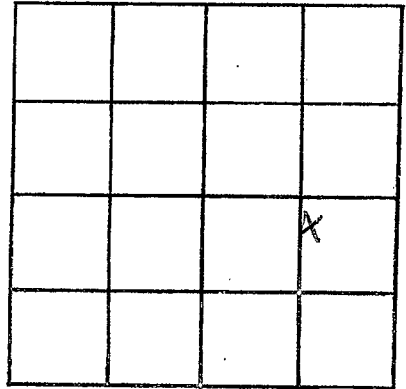

SECTION _____

Please indicate well location X.

ADDITIONAL INFORMATION

If more than one screen, show locations of each on sketch.