

TATE
H 56
7-12-72

MISSISSIPPI
BOARD OF WATER COMMISSIONERS
416 North State Street
Jackson, Mississippi 39201

WATER WELL DRILLERS LOG

CODED

7-12 1972 Harris Bros. Tate
date well completed firm name county well located

LANDOWNER: J. J. McKay

pt. 1
Senatobia
(mailing address)

WELL LOCATION:
sec 25 T 5 N R 6 E
Cln Barr
(distance) miles (direction) of (nearest town)

WELL PURPOSE:
(home, irrigation, municipal, industrial)

WELL COMPLETION DATA:

- (1) diameter (inches) 4
- (2) total depth (feet) 220
- (3) static water level (feet) 120 ^{below}/_{above} top of ground.
- (4) casing Plastic 206
4 (material) (depth)
4 (size) if telescope see back.
- (5) screen 14 206
(length) (depth to top)
008 Plastic
(size) (material)
- (6) pump 3/4 10
(HP) (yield gpm)
elec.
(type power)
- (7) electric log no
(yes or no)

(organization running log)
- (8) how well bottom plugged solid

description of formations encountered	from	to
top soil	0	20
red sand	20	65
fine sand & clay	65	140
fine sand	140	190
Coarse sand	190	220

CODED


OCT 18 1972

DRILLERS REMARKS:

MISS. BD. OF
WATER COMMISSIONERS

If well telescopes please sketch and show depths.

GROUND LEVEL

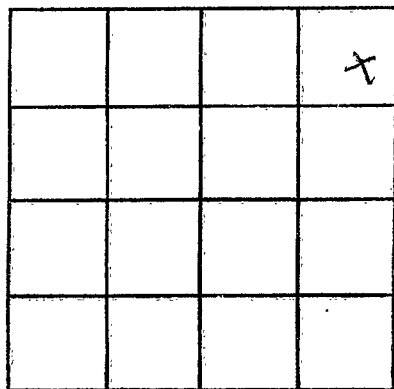

SECTION 25

Please indicate well location X.

ADDITIONAL INFORMATION

If more than one screen, show locations of each on sketch.