

TATE
H 58
10-18-72

MISSISSIPPI
BOARD OF WATER COMMISSIONERS
416 North State Street
Jackson, Mississippi 39201

CODED

WATER WELL DRILLERS LOG

10-18 1972 James A. Lipe TATE
date well completed firm name county well located

LANDOWNER: Allen Carter
Independence
Miss.
(mailing address)

description of formations encountered	from	to
Clay	0	20
Clay and sand	20	40
" " "	40	60
" " "	60	80
sand	80	180

WELL LOCATION:
sec. 30 T 5 N R 6 E
4 miles East of Independence
(distance) (direction) (nearest town)

WELL PURPOSE: HOME
(home, irrigation, municipal, industrial)

- WELL COMPLETION DATA:
- (1) diameter (inches) 4"
 - (2) total depth (feet) 180
 - (3) static water level (feet) 110 below top of ground.
 - (4) casing PVC, 170 (material), (depth)
4 (size) if telescope see back.
 - (5) screen 10, 170 (length), (depth to top)
4, PVC (size), (material)
 - (6) pump 3/4, 17 (HP), (yield gpm)
Elec. (type power)
 - (7) electric log NO (yes or no)
NO (organization running log)
 - (8) how well bottom plugged PVC plug

CODED


NOV - 1 1972

DRILLERS REMARKS:

MISS. BU. OF
ENGINEERS

If well telescopes please sketch and show depths.

GROUND LEVEL

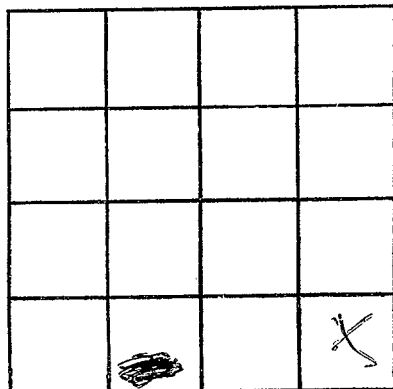

SECTION 30

Please indicate well location X.

ADDITIONAL INFORMATION

If more than one screen,
show locations of each on sketch.