

TATE
H 60
8-30-72

MISSISSIPPI
BOARD OF WATER COMMISSIONERS
416 North State Street
Jackson, Mississippi 39201

CODED

WATER WELL DRILLERS LOG

8-30-1972 date well completed Bob Smith firm name Tate county well located


LANDOWNER:	description of formations encountered	from	to
Billy Pover	clay silt		8
Boazville (mailing address)	gravel	8	20
WELL LOCATION:	Red sand	20	80
sec. 6 T 5 N R 6 E (5) (W)	Sand + gravel	80	120
1/2 miles WEST of Boazville (distance) (direction) (nearest town)	white clay	120	135
WELL PURPOSE: None (home, irrigation, municipal, industrial)	white sand	135	160
WELL COMPLETION DATA:			
(1) diameter (inches) 4			
(2) total depth (feet) 160			
(3) static water level (feet) 110 below top of ground.			
(4) casing Plastic 160 (material) (depth)			
(size) if telescope see back.			
(5) screen 20 140 (length) (depth to top)			
(size) (material)			
(6) pump 3/4 15 (HP) (yield gpm)			
(type power)			
(7) electric log No (yes or no)			
(organization running log)			
(8) how well bottom plugged plugged			
DRILLERS REMARKS:			

CODED

SEE 22

If well telescopes please sketch and show depths.

GROUND LEVEL

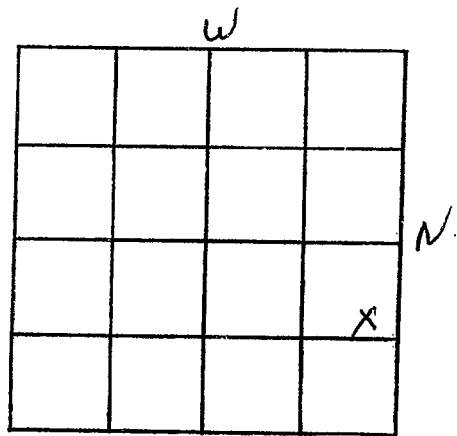

SECTION 6

Please indicate well location X.

ADDITIONAL INFORMATION

If more than one screen, show locations of each on sketch.