

TATE  
H 61  
9-10-72

MISSISSIPPI  
BOARD OF WATER COMMISSIONERS  
416 North State Street  
Jackson, Mississippi 39201

**CODED**

WATER WELL DRILLERS LOG

9-10 1972 Harris Late  
date well completed firm name county well located

LANDOWNER: Mass Ferguson

Rt 2  
Caldwater  
(mailing address)

description of formations encountered	from	to
<u>top soil</u>	<u>0</u>	<u>15</u>
<u>sand &amp; clay</u>	<u>15</u>	<u>125</u>
<u>coarse sand</u>	<u>125</u>	<u>120</u>

WELL LOCATION:  
sec. 10 T S N R 6 E W  
2 miles S of Independence  
(distance) (direction) (nearest town)

WELL PURPOSE: home  
(home, irrigation, municipal, industrial)

- WELL COMPLETION DATA:
- (1) diameter (inches) 4
  - (2) total depth (feet) 120
  - (3) static water level (feet) 80 below top of ground.
  - (4) casing Plastic, 113  
(material) (depth)  
4 if telescope see back.  
(size)
  - (5) screen 7', 113  
(length) (depth to top)  
208, Plastic  
(size) (material)
  - (6) pump 3/4, 7  
(HP) (yield gpm)  
elec.  
(type power)
  - (7) electric log no  
(yes or no)
  - (organization running log)
  - (8) how well bottom plugged solid


**CODED**

DRILLERS REMARKS:

MAR 12 1973

If well telescopes please sketch and show depths.

GROUND LEVEL

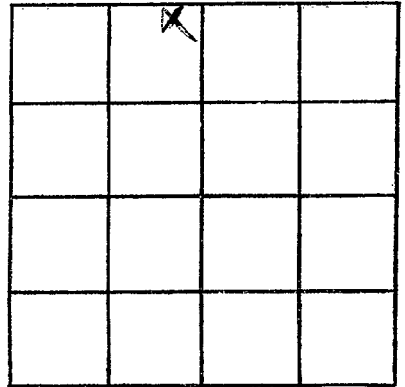

SECTION 10

Please indicate well location X.

ADDITIONAL INFORMATION

If more than one screen,  
show locations of each on sketch.