

TATE
H 62
11-20-72

MISSISSIPPI
BOARD OF WATER COMMISSIONERS
416 North State Street
Jackson, Mississippi 39201

CODED

WATER WELL DRILLERS LOG

11-20 1972 Harris Bros. Tate
date well completed firm name county well located

LANDOWNER: Ralph May
Rt. 2
Caldwater
(mailing address)

description of formations encountered	from to	
	from	to
<u>top soil</u>	<u>0</u>	<u>20</u>
<u>clay + sand</u>	<u>20</u>	<u>95</u>
<u>coarse sand</u>	<u>95</u>	<u>110</u>

WELL LOCATION:
sec. 2 T S N R 6 E
1 1/2 miles S of Independence
(distance) (direction) (nearest town)

WELL PURPOSE: home
(home, irrigation, municipal, industrial)


- WELL COMPLETION DATA:
- (1) diameter (inches) 4
 - (2) total depth (feet) 110
 - (3) static water level (feet) 80 below above top of ground.
 - (4) casing Plastic, 103,
(material) (depth)
4 if telescope see back.
(size)
 - (5) screen 7, 103
(length) (depth to top)
008 Plastic
(size) (material)
 - (6) pump 3/4, 7
(HP) (yield gpm)
elec
(type power)
 - (7) electric log no
(yes or no)
 - (organization running log)
 - (8) how well bottom plugged sealed

CODED

DRILLERS REMARKS:

If well telescopes please sketch and show depths.

GROUND LEVEL

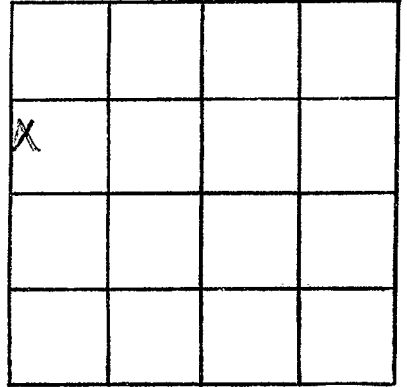

SECTION 2

Please indicate well location X.

ADDITIONAL INFORMATION

If more than one screen,
show locations of each on sketch.