

TATE
H 65
10-12-73

MISSISSIPPI
BOARD OF WATER COMMISSIONERS
416 North State Street
Jackson, Mississippi 39201

CODED

WATER WELL DRILLERS LOG

10-12 date well completed 19 23 Harris Bros. firm name Tate county well located

LANDOWNER: Ernes Brown
Rt. 1
Senatobia
(mailing address)

description of formations encountered	from	to
top soil	0	15
Clay + sand	15	85
Coarse sand	85	100

WELL LOCATION:
sec. 20 T S N R 6 E
2 1/2 miles N of Senatobia
(distance) (direction) (nearest town)

WELL PURPOSE: None
(home, irrigation, municipal, industrial)


- WELL COMPLETION DATA:
- (1) diameter (inches) 4
 - (2) total depth (feet) 100
 - (3) static water level (feet) 60 below top of ground.
 - (4) casing Plastic, 93
(material) (depth)
 - 4 if telescope see back.
(size)
 - (5) screen 7, 93
(length) (depth to top)
 - 000, Plastic
(size) (material)
 - (6) pump 3/4, 7
(HP) (yield gpm)
 - elec
(type power)
 - (7) electric log no
(yes or no)
 - (organization running log)
 - (8) how well bottom plugged solid

CODED

DRILLERS REMARKS:

If well telescopes please sketch and show depths.

GROUND LEVEL

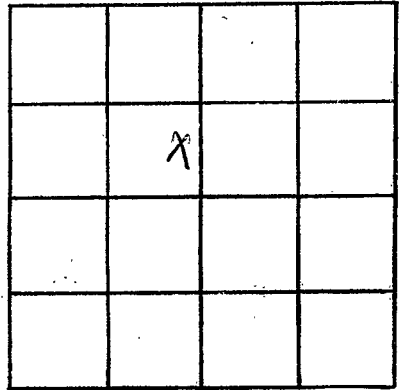

SECTION 20

Please indicate well location X.

ADDITIONAL INFORMATION

If more than one screen, show locations of each on sketch.