

TATE
H 66
8-25-73

MISSISSIPPI
BOARD OF WATER COMMISSIONERS
416 North State Street
Jackson, Mississippi 39201
WATER WELL DRILLERS LOG

CODED

8-25 1973 Harris Bros. Tate
date well completed firm name county well located

LANDOWNER: Archibald Towns
Rt. 2
Senatobia
(mailing address)

description of formations encountered	from	to
top soil	0	20
clay	20	80
course sand	80	100

WELL LOCATION:
sec. 16 T. 5 N. R. 6 E.
2 1/2 miles SE of Poplarville
(distance) (direction) (nearest town)

WELL PURPOSE: none
(home, irrigation, municipal, industrial)

- WELL COMPLETION DATA:
- (1) diameter (inches) 4
 - (2) total depth (feet) 100
 - (3) static water level (feet) 40 ^{below} top of ground.
 - (4) casing Plastic, 93, (material) (depth)
4 (size) If telescope see back.
 - (5) screen 7, 93 (length) (depth to top)
#08, Plastic (size) (material)
 - (6) pump 3/4, 7 (HP) (yield gpm)
elec. (type power)
 - (7) electric log NO (yes or no)
 - (organization running log)
 - (8) how well bottom plugged solid


CODED

DRILLERS REMARKS:

061 23

If well telescopes please sketch and show depths.

GROUND LEVEL

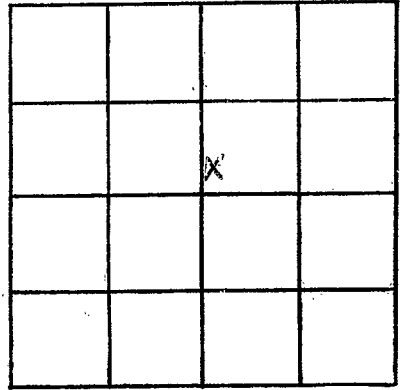

SECTION 16

Please indicate well location X.

ADDITIONAL INFORMATION

If more than one screen, show locations of each on sketch.