

LATE
H 67
6-6-73

MISSISSIPPI
BOARD OF WATER COMMISSIONERS
416 North State Street
Jackson, Mississippi 39201

CODED

WATER WELL DRILLERS LOG

6-6 1973 Harris Bros. Late
date well completed firm name county well located

LANDOWNER: <u>Tom P. Thornton</u>	description of formations encountered	from	to
<u>Rt 2 Box 122</u> <u>Coldwater</u> (mailing address)			
WELL LOCATION: sec <u>13</u> T <u>5</u> N R <u>6</u> E <u>1 1/2</u> miles <u>N</u> of <u>Bass</u> (distance) (direction) (nearest town)	<u>top soil</u>	<u>0</u>	<u>15</u>
WELL PURPOSE: <u>home</u> (home, irrigation, municipal, industrial)	<u>red sand</u>	<u>15</u>	<u>40</u>
WELL COMPLETION DATA: (1) diameter (inches) <u>4</u> (2) total depth (feet) <u>100</u> (3) static water level (feet) <u>60</u> ^{below} _{above} top of ground. (4) casing <u>Plastic</u> , <u>93</u> (material) (depth) <u>4</u> If telescope see back. (size) (5) screen <u>7</u> , <u>93</u> (length) (depth to top) <u>008</u> , <u>Plastic</u> (size) (material) (6) pump <u>3/4</u> , <u>10</u> (HP) (yield gpm) <u>elec</u> (type power) (7) electric log <u>no</u> (yes or no) (organization running log) (8) how well bottom plugged <u>solid</u>	<u>fine sand</u>	<u>40</u>	<u>85</u>
	<u>Coarse sand</u>	<u>85</u>	<u>100</u>
DRILLERS REMARKS:			


CODED

DATE 2-23-1973

MISS. DEPT. OF WATER CONTROL

If well telescopes please sketch and show depths.

GROUND LEVEL

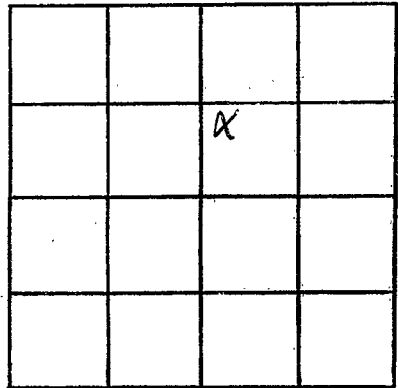

SECTION 13

Please indicate well location X.

ADDITIONAL INFORMATION

If more than one screen,
show locations of each on sketch.