

LATE
H 68
8-28-73

MISSISSIPPI
 BOARD OF WATER COMMISSIONERS
 416 North State Street
 Jackson, Mississippi 39201

CODED

WATER WELL DRILLERS LOG

8-28 1973 Harris Bros. Late
 date well completed firm name county well located

LANDOWNER: <u>Earnest Parker</u>	description of formations encountered	from	to
<u>Rt. 2</u> <u>Coldwater</u> (mailing address)			
WELL LOCATION: sec. <u>16</u> T <u>S</u> N R <u>6</u> E <u>2 1/2</u> miles <u>SE</u> of <u>Pragville</u> (distance) (direction) (nearest town)	<u>top soil</u>	<u>0</u>	<u>20</u>
WELL PURPOSE: <u>home</u> (home, irrigation, municipal, industrial)	<u>Clay</u>	<u>20</u>	<u>80</u>
WELL COMPLETION DATA: (1) diameter (inches) <u>4</u> (2) total depth (feet) <u>100</u> (3) static water level (feet) <u>40</u> ^{below} _{above} top of ground. (4) casing <u>plastic</u> , <u>93</u> (material) (depth) <u>4</u> if telescope see back. (size) (5) screen <u>7</u> , <u>43</u> (length) (depth to top) <u>008</u> , <u>plastic</u> (size) (material) (6) pump <u>3/4</u> , <u>7</u> (HP) (yield gpm) <u>elec.</u> (type power) (7) electric log <u>NO</u> (yes or no) (organization running log) (8) how well bottom plugged <u>solid</u>	<u>Coarse sand</u>	<u>80</u>	<u>100</u>
DRILLERS REMARKS:			


CODED

1973 OCT 10 10 52 AM

MISS. BD. OF
 WATER COMMISSIONERS

If well telescopes please sketch and show depths.

GROUND LEVEL

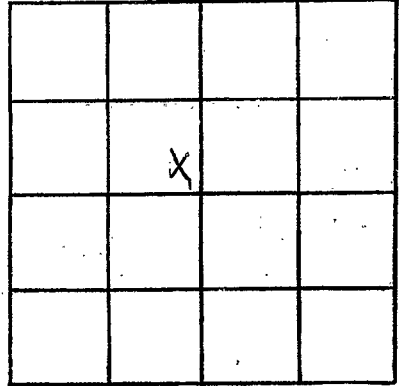

SECTION 16

Please indicate well location X.

ADDITIONAL INFORMATION

If more than one screen,
show locations of each on sketch.