

MISSISSIPPI  
BOARD OF WATER COMMISSIONERS  
416 North State Street  
Jackson, Mississippi 39201

WATER WELL DRILLERS LOG

CODED

LATE  
H 75  
10-15-73

10-15 date well completed 19 73 firm name Harris Bros Lata county well located

LANDOWNER: <i>G. W. Williams</i>	description of formations encountered	from	to
<i>RT. 4</i>	<i>top soil</i>	<i>0</i>	<i>15</i>
<i>Coldwater</i> (mailing address)	<i>clay + sand</i>	<i>15</i>	<i>85</i>
	<i>coarse sand</i>	<i>85</i>	<i>100</i>

WELL LOCATION:  
sec. 10 T 5 N R 6 E  
2 1/2 miles S of Independence  
(distance) (direction) (nearest town)

WELL PURPOSE: *home*  
(home, irrigation, municipal, industrial)

- WELL COMPLETION DATA:
- diameter (inches) 4
  - total depth (feet) 100
  - static water level (feet) 60 ~~below~~ above top of ground.
  - casing plastic, 93  
(material) (depth)  
4 If telescope see back.  
(size)
  - screen 7, 93  
(length) (depth to top)  
1008, plastic  
(size) (material)
  - pump 3/4, 10  
(HP) (yield gpm)  
sheer  
(type power)
  - electric log no  
(yes or no)
- (organization running log)
- (8) how well bottom plugged solid

CODED


RECORDED  
INDEXED  
FEB 22 1974

DRILLERS REMARKS:

MISS. DD. OF WATER COMMISSIONERS

If well telescopes please sketch and show depths.

GROUND LEVEL

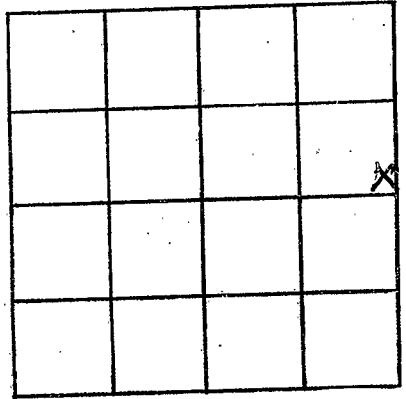

SECTION 10

Please indicate well location X.

ADDITIONAL INFORMATION

If more than one screen, show locations of each on sketch.