

MISSISSIPPI
BOARD OF WATER COMMISSIONERS
416 North State Street
Jackson, Mississippi 39201

CODED

WATER WELL DRILLERS LOG

LATE
H 76
11-1-73

11-1 19 73 Harris Bros. Late
date well completed firm name county well located

LANDOWNER: Ratie Anderson Rt. 1
Senetobia
(mailing address)

description of formations encountered	from	to
top soil	0	20
fine sand	20	85
Coarse sand	85	100

WELL LOCATION:
sec 21 T 5 N R 6 E
2 1/2 miles N of Senetobia
(distance) (direction) (nearest town)

WELL PURPOSE: none
(home, irrigation, municipal, industrial)

- WELL COMPLETION DATA:
- (1) diameter (inches) 4
 - (2) total depth (feet) 100
 - (3) static water level (feet) 60 below top of ground.
 - (4) casing Plastic, 93
(material) (depth)
4 If telescope see back.
(size)
 - (5) screen 7, 93
(length) (depth to top)
008, Plastic
(size) (material)
 - (6) pump 3/4, 7
(HP) (yield gpm)
elec.
(type power)
 - (7) electric log no
(yes or no)
 - (8) how well bottom plugged solid


CODED

DRILLERS REMARKS:

RECORDED
INDEXED
FEB 22 1974

If well telescopes please sketch and show depths.

GROUND LEVEL

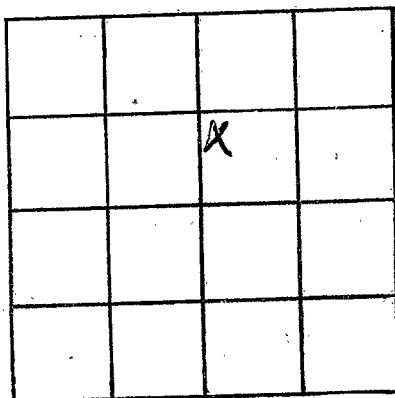

SECTION 21

Please indicate well location X.

ADDITIONAL INFORMATION

If more than one screen, show locations of each on sketch.