

TATE  
H 78  
1-25-74

MISSISSIPPI  
BOARD OF WATER COMMISSIONERS  
416 North State Street  
Jackson, Mississippi 39201

WATER WELL DRILLERS LOG

CODED

1-25 1974 Hicks Bros. Well Co. Tate  
date well completed firm name county well located

LANDOWNER: Parson  
Parson - Rt 1 Box 355  
Semtober, Miss.  
(mailing address)

description of formations encountered	from	to
<u>Red Clay &amp; Red Sand</u>	<u>0</u>	<u>15</u>
<u>white sand &amp; blue clay</u>	<u>15</u>	<u>45</u>
<u>white sand</u>	<u>45</u>	<u>120</u>

WELL LOCATION:  
sec. 8 T. 5 S. R. 6 E.  
7 miles NE of Semtober  
(distance) (direction) (nearest town)

WELL PURPOSE: drinking  
(home, irrigation, municipal, industrial)

- WELL COMPLETION DATA:
- (1) diameter (inches) 4
  - (2) total depth (feet) 120
  - (3) static water level (feet) 20 below top of ground
  - (4) casing Plastic, 120,  
(material) (depth)  
(size) if telescope see back.
  - (5) screen 4ft, 116  
(length) (depth to top)  
Wire, Strand  
(size) (material)
  - (6) pump 3/4, 10  
(HP) (yield gpm)  
Electric, 120  
(type power)
  - (7) electric log No  
(yes or no)  
(organization running log)
  - (8) how well bottom plugged Cap

CODED

RECORDED


FEB 28 1974

MISS. B. ...

DRILLERS REMARKS:

If well telescopes please sketch and show depths.

GROUND LEVEL

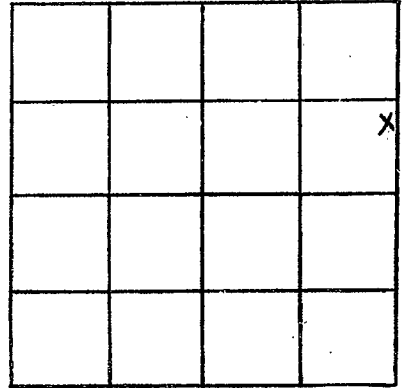

SECTION 8

Please indicate well location X.

ADDITIONAL INFORMATION

If more than one screen,  
show locations of each on sketch.