

TATE
H 80
3-22-74

MISSISSIPPI
BOARD OF WATER COMMISSIONERS
416 North State Street
Jackson, Mississippi 39201

CODED

WATER WELL DRILLERS LOG

3-22-1974 date well completed
Hicks Bros. Well Co firm name
Tate county well located

LANDOWNER: T. H. Saunders
Route 3, Caldwell, Miss.
(mailing address)

description of formations encountered	from	to
Red clay	0	15
Red clay & sand	15	30
White sand & clay	30	60
White sand	60	135

WELL LOCATION:
sec. 6 T 5 N R. 6 E
1 miles SE of Pegville
(distance) (direction) (nearest town)

WELL PURPOSE:
(home, irrigation, municipal, industrial)

WELL COMPLETION DATA:

- (1) diameter (inches) 4 1/2 in.
- (2) total depth (feet) 135
- (3) static water level (feet) 90 below top of ground.
- (4) casing Plastic, 135, (material) (depth)
- (size) if telescope see back.
- (5) screen 4 ft, 131 (length) (depth to top)
- (size) (material)
- (6) pump 3/4 10 (HP) (yield gpm)
- Electric 230 (type power)
- (7) electric log 70 (yes or no)
- (organization running log)
- (8) how well bottom plugged Cap


CODED

DRILLERS REMARKS:

APR 25 1974

If well telescopes please sketch and show depths.

GROUND LEVEL

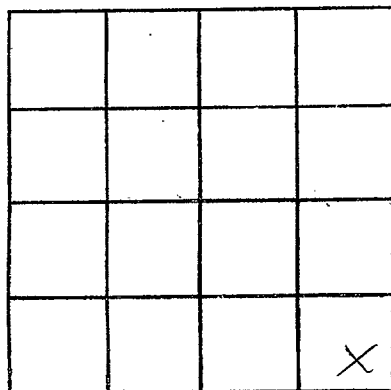

SECTION 6

Please indicate well location X.

ADDITIONAL INFORMATION

If more than one screen,
show locations of each on sketch.