

MISSISSIPPI  
BOARD OF WATER COMMISSIONERS  
416 North State Street  
Jackson, Mississippi 39201

CODED

WATER WELL DRILLERS LOG

8-73 1974 Shicks Bros. Mfg. Co. Leflore  
date well completed firm name county well located

LANDOWNER:

description of formations encountered

from to

James E. Smith -  
Colburn, Miss.  
(mailing address)

<u>Red clay</u>	<u>0</u>	<u>15</u>
<u>Red Clay + Sand</u>	<u>15</u>	<u>30</u>
<u>Red Sand</u>	<u>30</u>	<u>45</u>
<u>White Sand</u>	<u>45</u>	<u>90</u>
<u>White Sand + clay</u>	<u>90</u>	<u>105</u>
<u>White Sand</u>	<u>105</u>	<u>130</u>

WELL LOCATION:

sec. 11 T. 5 N R. 6 E  
3 1/2 miles SE of Woodville  
(distance) (direction) (nearest town)

WELL PURPOSE: Home  
(home, irrigation, municipal, industrial)

WELL COMPLETION DATA:


- (1) diameter (inches) 4 1/2 in
- (2) total depth (feet) 130
- (3) static water level (feet) 80 below top of ground.
- (4) casing Plastic, 130,  
(material) (depth)  
if telescope see back.
- (5) screen 4 ft, 136  
(length) (depth to top)  
4 in., Screen  
(size) (material)
- (6) pump 1/2 10  
(HP) (yield gpm)  
Electric 220  
(type power)
- (7) electric log no  
(yes or no)
- (organization running log)
- (8) how well bottom plugged cap

RECEIVED  
SEP 25 1974

DRILLERS REMARKS:

If well telescopes please sketch and show depths.

GROUND LEVEL

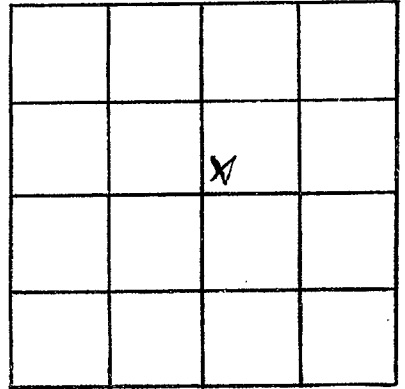

SECTION 11

Please indicate well location X.

ADDITIONAL INFORMATION

If more than one screen, show locations of each on sketch.