

TATE
H 85
8-23-74

MISSISSIPPI
BOARD OF WATER COMMISSIONERS
416 North State Street
Jackson, Mississippi 39201

CODED

WATER WELL DRILLERS LOG

8-23-1974 date well completed
N Hicks Bros. Wells firm name
Tate county well located

LANDOWNER: owner

Ed. Murray -
Pct 1, Senatobia, Miss
(mailing address)

WELL LOCATION:

sec 13 T 5 N R 6 E
3 miles N of Barro
(distance) (direction) (nearest town)

WELL PURPOSE: Home
(home, irrigation, municipal, industrial)

WELL COMPLETION DATA:

- (1) diameter (inches) 4 in
- (2) total depth (feet) 145
- (3) static water level (feet) 20 below top of ground
- (4) casing Plastic, 145
(material) (depth)
- (size) if telescope see back.
- (5) screen 4 ft, 141
(length) (depth to top)
4 in, Gravel
(size) (material)
- (6) pump 1/2, 10
(HP) (yield gpm)
Electric 220
(type power)
- (7) electric log no
(yes or no)
- (organization running log)
- (8) how well bottom plugged cap


description of formations encountered	from	to
Red clay	0	15
Red Sand	15	30
white Sand	30	90
white Sand + clay	90	105
white Sand	105	145

RECEIVED
SEP 25 1974

DRILLERS REMARKS:

If well telescopes please sketch and show depths.

GROUND LEVEL

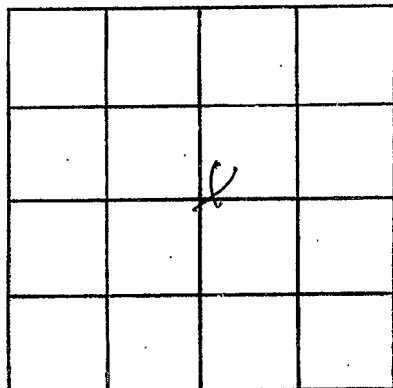

SECTION LS

Please indicate well location X.

ADDITIONAL INFORMATION

If more than one screen,
show locations of each on sketch.