

DATE
H 86
8-29-74

MISSISSIPPI
 BOARD OF WATER COMMISSIONERS
 416 North State Street
 Jackson, Mississippi 39201

WATER WELL DRILLERS LOG

8-29-74 1974 W. B. Mason Fato
 date well completed firm name county well located

LANDOWNER:
Roy Moore
Independence Miss.
 (mailing address)

| description of formations encountered | from | to |
|---------------------------------------|-----------|-----------|
| <u>Clay Lint</u> | <u>0</u> | <u>8</u> |
| <u>Red sand</u> | <u>8</u> | <u>40</u> |
| <u>white sand</u> | <u>40</u> | <u>92</u> |

WELL LOCATION:
 sec. 9 T 5 N R. 6 E
1 1/2 miles South of Boonville
 (distance) (direction) (nearest town)

WELL PURPOSE: Home
 (home, irrigation, municipal, industrial)

- WELL COMPLETION DATA:
- (1) diameter (inches) 4"
 - (2) total depth (feet) 92'
 - (3) static water level (feet) 45' below top of ground.
 - (4) casing Plasti, 82'
 (material) (depth)
4" if telescope see back.
 (size)
 - (5) screen 10', 82'
 (length) (depth to top)
4", Plasti
 (size) (material)
 - (6) pump 1/3, 10
 (HP) (yield gpm)
electric
 (type power)
 - (7) electric log No
 (yes or no)
 (organization running log)
 - (8) how well bottom plugged cap

CODED


RECEIVED
 DEC 27 1974

MISS. Bd. OF WATER COMMISSIONERS

DRILLERS REMARKS:

If well telescopes please sketch and show depths.

GROUND LEVEL

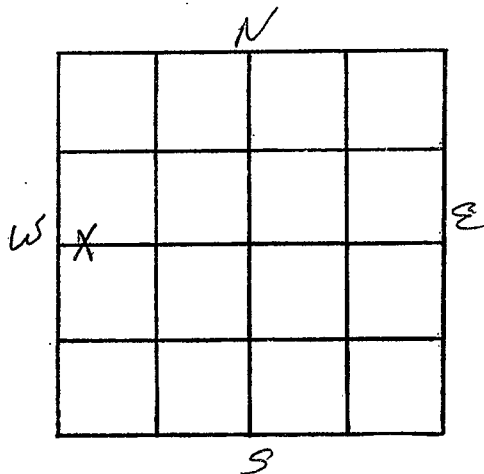

SECTION 9

Please indicate well location X.

ADDITIONAL INFORMATION

If more than one screen, show locations of each on sketch.