

TATE
H 87
6-29-74

MISSISSIPPI
BOARD OF WATER COMMISSIONERS
416 North State Street
Jackson, Mississippi 39201

CODED

WATER WELL DRILLERS LOG

6-29-74 date well completed W.A. Mason firm name Tate county well located

LANDOWNER:
Johnny B. Johnson
P.O. 3, Senatobia Miss
(mailing address)

| description of formations encountered | from | to |
|---------------------------------------|------|-----|
| Clay fert | 70 | 12 |
| Red sand | 12 | 16 |
| White sand | 16 | 60 |
| hard rock | 60 | 61 |
| Blue clay | 61 | 100 |

WELL LOCATION:
sec 21 T 5 N R 6 E
1/4 miles South of Loxahone
(distance) (direction) (nearest town)

WELL PURPOSE: Home
(home, irrigation, municipal, industrial)

WELL COMPLETION DATA:

(1) diameter (inches) 4"

(2) total depth (feet) 60'

(3) static water level (feet) 8' below top of ground.

(4) casing Plastic, 50' (material) (depth)
4" if telescope see back. (size)

(5) screen 10' 50' (length) (depth to top)
4" Plastic (size) (material)

(6) pump 1/4 7 (HP) (yield gpm)
Electric (type power)

(7) electric log No (yes or no)
(organization running log)

(8) how well bottom plugged cap

CODED


RECEIVED
MISSISSIPPI
DEC 27 1974

DRILLERS REMARKS:

MISS. BD. OF WATER COMM.

If well telescopes please sketch and show depths.

GROUND LEVEL

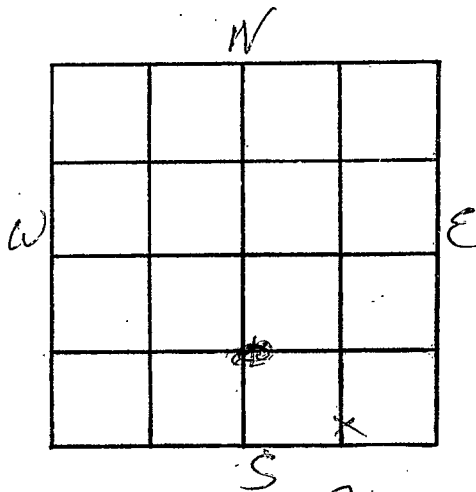

SECTION 21

Please indicate well location X.

ADDITIONAL INFORMATION

If more than one screen, show locations of each on sketch.