

TATE  
H 88  
7-19-74

MISSISSIPPI  
BOARD OF WATER COMMISSIONERS  
416 North State Street  
Jackson, Mississippi 39201

CODED

WATER WELL DRILLERS LOG

7-19 1974 date well completed  
Harris Bros. firm name  
Lata county well located

LANDOWNER: R. J. Lovat  
Pt. 2  
Coldwater  
(mailing address)

description of formations encountered	from	to
top soil	0	15
white clay	15	45
clay sand	45	110
coarse sand	110	120

WELL LOCATION:  
sec. 5 T 5 N R 6 E  
3/4 miles S of Prossville  
(distance) (direction) (nearest town)

WELL PURPOSE: none  
(home, irrigation, municipal, industrial)

- WELL COMPLETION DATA:
- (1) diameter (inches) 4
  - (2) total depth (feet) 120
  - (3) static water level (feet) 80  below  above top of ground.
  - (4) casing Plastic, 113 (material) (depth)  
4 (size) if telescope see back.
  - (5) screen 7 (length), 113 (depth to top)  
008 (size), Plastic (material)
  - (6) pump 3/4 (HP), 10 (yield gpm)  
elec. (type power)
  - (7) electric log no (yes or no)
  - (8) how well bottom plugged solid

CODED



REGISTERED

MAR 17 1974

DRILLERS REMARKS:

If well telescopes please sketch and show depths.

GROUND LEVEL

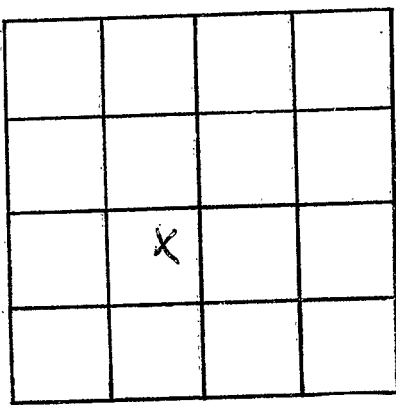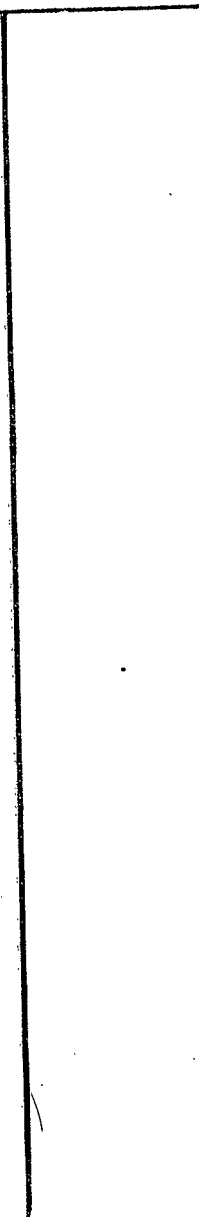

SECTION 5

Please indicate well location 'X'.

ADDITIONAL INFORMATION

Lined area for additional information.

If more than one screen, show locations of each on sketch.