

LATE  
H 90  
9-4-74

MISSISSIPPI  
BOARD OF WATER COMMISSIONERS  
416 North State Street  
Jackson, Mississippi 39201

WATER WELL DRILLERS LOG

CODED

9-4 1974 Harris Bros. Late  
date well completed firm name county well located

LANDOWNER: Jack E. Turner  
Rt. 2 Box 516  
Coldwater  
(mailing address)

description of formations encountered	from	to
<u>top soil</u>	<u>0</u>	<u>15</u>
<u>clay + sand</u>	<u>15</u>	<u>85</u>
<u>coarse sand</u>	<u>85</u>	<u>100</u>

WELL LOCATION:  
sec. 9 T. 5 N R. 6 E  
2 miles SE of Pragville  
(distance) (direction) (nearest town)

WELL PURPOSE: home  
(home, irrigation, municipal, industrial)


- WELL COMPLETION DATA:
- (1) diameter (inches) 4
  - (2) total depth (feet) 100
  - (3) static water level (feet) 60 (below above)  
top of ground.
  - (4) casing Plastic, 93  
(material) (depth)  
4 if telescope see back.  
(size)
  - (5) screen 7, 93  
(length) (depth to top)  
008, Plastic  
(size) (material)
  - (6) pump 3/4, 7  
(HP) (yield gpm)  
elec.  
(type power)
  - (7) electric log no  
(yes or no)
  - (organization running log)
  - (8) how well bottom plugged solid

DRILLERS REMARKS:

MAR 17 1975

If well telescopes please sketch and show depths.

GROUND LEVEL

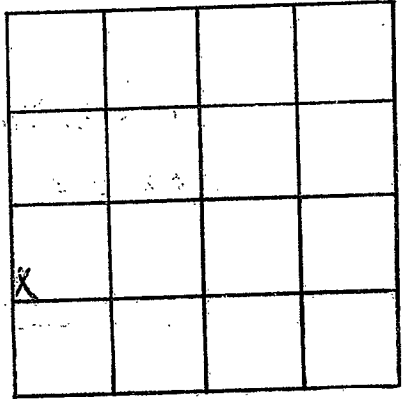

SECTION 9

Please indicate well location X.

ADDITIONAL INFORMATION

If more than one screen,  
show locations of each on sketch.