

MISSISSIPPI DEPARTMENT OF NATURAL RESOURCES
Bureau of Land and Water Resources
 Southport Mall
 P.O. Box 10631
 Jackson, Mississippi 39209
WATER WELL DRILLERS LOG

COPED

H-92
 TATE
 7/4/80

7-4-1980 date well completed 80 Dicks Wells firm name Tate county well located

LANDOWNER:
 Leo Miller

description of formations encountered

(mailing address)

Clay 0 30
 red sand 30 90

WELL LOCATION:
 sec. 13 T 5 N R 6 E
 Barr S W
 miles of (distance) (direction) of (nearest town)

white sand 90 140
 CODED

WELL PURPOSE: Home
 (home, irrigation, municipal, industrial)

WELL COMPLETION DATA:
 (1) diameter (inches) 4 in
 (2) total depth (feet) 140
 (3) static water level (feet) 80 below top of ground.
 (4) casing Plastic 140 (material) (depth)
 (size) if telescope see back.
 (5) screen 7 ft 133 (length) (depth to top)
 4 in gravel (size) (material)
 (6) pump 1/2 10 (HP) (yield gpm)
 220 (type power)
 (7) electric log No (yes or no)


(organization running log)
 (8) how well bottom plugged Cap

DRILLERS REMARKS:

DEPT. OF NATURAL RESOURCES
 BUREAU OF LAND & WATER RESOURCES
 SEP 4 - 1980
RECEIVED

If well telescopes please sketch and show depths.

GROUND LEVEL

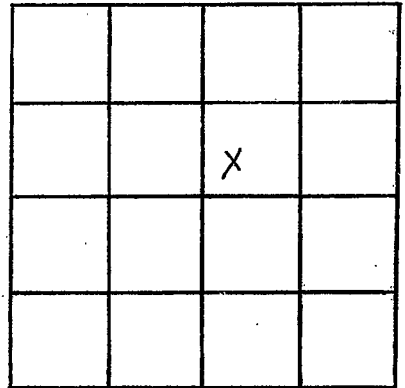

SECTION _____

Please indicate well location X.

ADDITIONAL INFORMATION

If more than one screen,
show locations of each on sketch.