

MISSISSIPPI DEPARTMENT OF NATURAL RESOURCES

Bureau of Land and Water Resources

Southport Mall

P.O. Box 10631

Jackson, Mississippi 39209

WATER WELL DRILLERS LOG

CODED

TATE  
H 93  
2/18/81

2-18-81 date well completed 1981 Links Wells firm name T. Tate county well located

LANDOWNER: Burton Dickerson

description of formations encountered	from	to
Red sand	0	50
Gravel	50	95
White sand	95	105

Rt. 1  
Serv. Station No.  
(mailing address)

WELL LOCATION:  
sec 28 T 5 N R 6 E  
1/2 miles W of Jackson  
(distance) (direction) (nearest town)

WELL PURPOSE: Drain  
(home, irrigation, municipal, industrial)

WELL COMPLETION DATA:

- (1) diameter (inches) 4
- (2) total depth (feet) 155
- (3) static water level (feet) 90 below above top of ground.
- (4) casing PVC, 155  
(material) (depth)  
       if telescope see back.  
(size)
- (5) screen 15', 140'  
(length) (depth to top)  
4", Gravel & Slotted  
(size) (material)
- (6) pump 2, 30  
(HP) (yield gpm)  
220V  
(type power)
- (7) electric log No  
(yes or no)  
        
(organization running log)
- (8) how well bottom plugged Cap

DRILLERS REMARKS:


DEPT OF NATURAL RESOURCES  
BUREAU OF LAND & WATER RESOURCES

MAR 18 1981

RECEIVED

If well telescopes please sketch and show depths.

GROUND LEVEL

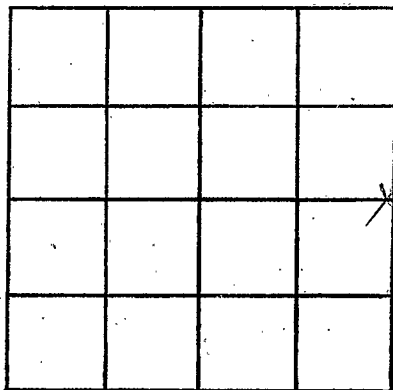

SECTION 28

Please indicate well location X.

ADDITIONAL INFORMATION

If more than one screen, show locations of each on sketch.